

Newton
M 2002
12-12-75

MISSISSIPPI
 BOARD OF WATER COMMISSIONERS
 416 North State Street
 Jackson, Mississippi 39201

WATER WELL DRILLERS LOG

12-12-75 ^{13P} McDONALD-HILL NEWTON
 date well completed firm name county well located

LANDOWNER: MRS C. A. BUILLEN
PH1 CHUNNY
 (mailing address)

WELL LOCATION:
 sec. 27 T. 6 N R. 13 E
2 miles WEST of CHUNNY
 (distance) (direction) (nearest town)

WELL PURPOSE: HOME
 (home, irrigation, municipal, industrial)

WELL COMPLETION DATA:
 (1) diameter (inches) 4"
 (2) total depth (feet) 200'
 (3) static water level (feet) 62' below/above top of ground.
 (4) casing DPC 82'
 (material) (depth)
4" If telescope see back.
 (size)
 (5) screen _____
 (length) (depth to top)
 (size) (material)
 (6) pump 6.5 JET 6
 (HP) (yield gpm)
E
 (type power)
 (7) electric log _____
 (yes or no)
 (organization running log)
 (8) how well bottom plugged OPEN


description of formations encountered	from	to
<u>Clay</u>	<u>0</u>	<u>18</u>
<u>Clay sand</u>	<u>18</u>	<u>48</u>
<u>Shale</u>	<u>48</u>	<u>90</u>
<u>Shale & Rock</u>	<u>90</u>	<u>185</u>
<u>COARSE SAND</u>	<u>185</u>	<u>200</u>

DEC 22 1975

MISS. BD. OF WATER COMMISSIONERS

If well telescopes please sketch and show depths.

GROUND LEVEL

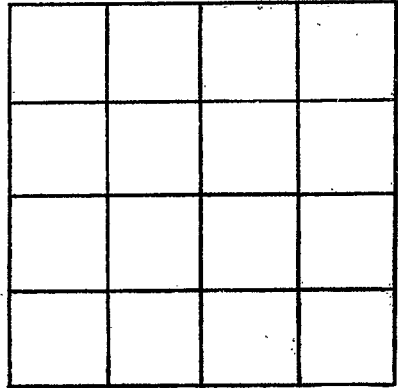

SECTION _____

Please indicate well location X.

ADDITIONAL INFORMATION

If more than one screen, show locations of each on sketch.