

NEWTON
M 2004
6-28-76

MISSISSIPPI
BOARD OF WATER COMMISSIONERS
 416 North State Street
 Jackson, Mississippi 39201

WATER WELL DRILLERS LOG

6.28.76 19 **MCDONALD HILL** **NEWTON**
 date well completed firm name county well located

LANDOWNER:
SHIRLEY LOGAN
Chunky
 (mailing address)

WELL LOCATION:
 sec. 26 T. 6 N R. 13 E
 S W
1 miles WEST of CHUNKY
 (distance) (direction) (nearest town)

WELL PURPOSE: HOUSE
 (home, irrigation, municipal, industrial)

- WELL COMPLETION DATA:**
- (1) diameter (inches) 4 1/2"
 - (2) total depth (feet) 180'
 - (3) static water level (feet) 28' below/above top of ground.
 - (4) casing PVC 42'
 (material) (depth)
4 1/2" If telescope see back.
 (size)
 - (5) screen _____
 (length) (depth to top)
 (size) (material)
 - (6) pump 1/2 JET 8
 (HP) (yield gpm)
E
 (type power)
 - (7) electric log _____
 (yes or no)
 (organization running log)
 - (8) how well bottom plugged OPEN

description of formations encountered	from	to
<u>Clay</u>	<u>0</u>	<u>16</u>
<u>Sandy</u>	<u>16</u>	<u>36</u>
<u>Shale</u>	<u>36</u>	<u>78</u>
<u>Road cut Shale</u>	<u>18</u>	<u>140</u>
<u>Sand</u>	<u>140</u>	<u>180</u>

RECEIVED


JUL - 2 1976

MISS. BO. OF WATER COM

DRILLERS REMARKS:

If well telescopes please sketch and show depths.

GROUND LEVEL

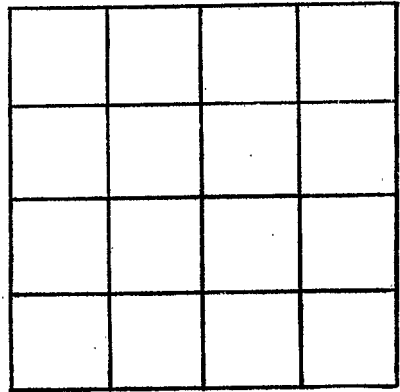

SECTION _____

Please indicate well location X.

ADDITIONAL INFORMATION

If more than one screen,
show locations of each on sketch.