

NEWTON  
M 2005  
8-10-76

MISSISSIPPI  
 BOARD OF WATER COMMISSIONERS  
 416 North State Street  
 Jackson, Mississippi 39201

WATER WELL DRILLERS LOG

8.10.76 <sup>13A</sup> McDONALD HILL NEWTON  
 date well completed firm name county well located

LANDOWNER:	description of formations encountered	from	to
<u>JACQUELENA GALLOWAY</u>	<u>Clay</u>	<u>0</u>	<u>16</u>
<u>Hickory Miss</u> (mailing address)	<u>Shale</u>	<u>16</u>	<u>33</u>
WELL LOCATION:	<u>Rock shale</u>	<u>33</u>	<u>100</u>
sec. <u>29</u> T. <u>6N</u> R. <u>10E</u>	<u>Green sand</u>	<u>100</u>	<u>12</u>
<u>11</u> <u>6S</u> <u>13W</u>	<u>Shale</u>	<u>72</u>	<u>90</u>
<u>2</u> miles <u>NORTH</u> of <u>Phonak</u>	<u>Rock shale</u>	<u>90</u>	<u>182</u>
(distance) (direction) (nearest town)	<u>Sand</u>	<u>182</u>	<u>200</u>

WELL PURPOSE: Home  
 (home, irrigation, municipal, industrial)

- WELL COMPLETION DATA:
- (1) diameter (inches) 4"
  - (2) total depth (feet) 200'
  - (3) static water level (feet) 60' below top of ground.
  - (4) casing PVC, 33'  
(material) (depth)  
4"  
(size) If telescope see back.
  - (5) screen \_\_\_\_\_  
(length) (depth to top)  
(size) (material)
  - (6) pump 1/2 JET, 6  
(HP) (yield gpm)  
F  
(type power)
  - (7) electric log \_\_\_\_\_  
(yes or no)  
(organization running log)
  - (8) how well bottom plugged OPEN


DRILLERS REMARKS:

RECEIVED  
 AUG 16 1976

MISSISSIPPI BOARD OF WATER COMMISSIONERS

If well telescopes please sketch and show depths.

GROUND LEVEL

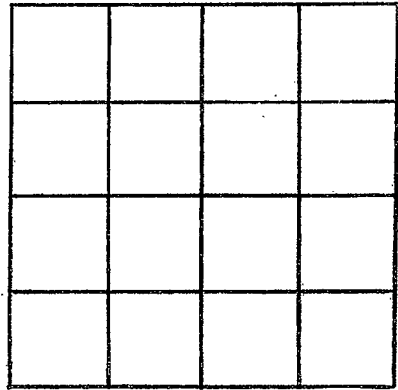

SECTION \_\_\_\_\_

Please indicate well location X.

ADDITIONAL INFORMATION

If more than one screen, show locations of each on sketch.