

Newton
M 2006
8-13-76

MISSISSIPPI
BOARD OF WATER COMMISSIONERS
416 North State Street
Jackson, Mississippi 39201

WATER WELL DRILLERS LOG

8, 13, 76 ^{13P} 19 McDonald & Hill NEWTON
date well completed firm name county well located

LANDOWNER:

LARRY REEVES

description of formations encountered

from

to

Clay sand

8

16

R#1 Box 1240 Hickory
(mailing address)

Shale

16

33

WELL LOCATION:

sec. 28 T. 6 N. S. R. 13 E

R. 13 E

Part of Hill

33

68

3 miles WEST of Chunka
(distance) (direction) (nearest town)

Masson sand

60

76

WELL PURPOSE: Home
(home, irrigation, municipal, industrial)

Shale to Rock

76

188

WELL COMPLETION DATA:

- (1) diameter (inches) 4"
- (2) total depth (feet) 230'
- (3) static water level (feet) 55' below top of ground.

(4) casing PVC 32'
(material) (depth)

4" if telescope see back.
(size)

(5) screen
(length) (depth to top)

(size) (material)

(6) pump 2500 8
(HP) (yield gpm)

E
(type power)

(7) electric log
(yes or no)

(organization running log)

(8) how well bottom plugged OPEN

RECEIVED


AUG 18 1976

MISS. BD. OF WATER COMMISSIONERS

DRILLERS REMARKS:

If well telescopes please sketch and show depths.

GROUND LEVEL

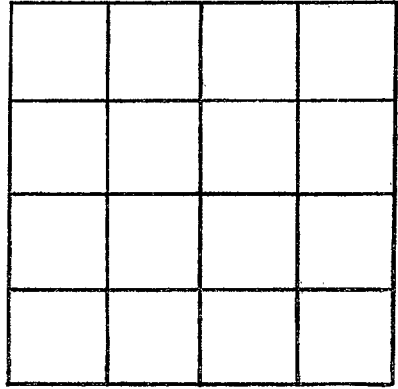

SECTION _____

Please indicate well location X.

ADDITIONAL INFORMATION

If more than one screen, show locations of each on sketch.