

NEWTON
M 2007
1-29-77

MISSISSIPPI
BOARD OF WATER COMMISSIONERS
416 North State Street
Jackson, Mississippi 39201

WATER WELL DRILLERS LOG

13P 1977 HAROLD POOLE NEWTON
date well completed firm name county well located

LANDOWNER:
W.B. SNOWDEN
RT. 1, CHUNKEY, MISS.
(mailing address)

WELL LOCATION:
sec. 11 T. 6N R. 13E
4 miles N of CHUNKEY
(distance) (direction) (nearest town)

WELL PURPOSE:
(home, irrigation, municipal, industrial)

WELL COMPLETION DATA:
(1) diameter (inches) 4"
(2) total depth (feet) 236'
(3) static water level (feet) 146' below top of ground.
(4) casing 4" PVC, 153'
(material) (depth)
_____ if telescope see back.
(size) _____
(5) screen OPEN
(length) (depth to top)
_____ (size) _____ (material)
(6) pump 1/2 SUB 7
(HP) 14.5 yield (gpm)
220 ELECTRIC
(type power)
(7) electric log _____
(yes or no)
_____ (organization running log)
(8) how well bottom plugged OPEN

description of formations encountered	from	to
RED SURFACE	0'	8'
CLAY		
SAND	8'	35'
BLUE CLAY	35'	51'
ROCK IN LAYERS	51'	146'
LIGHT BLUE CLAY	146'	153'
ROCK	153'	181'
LIGHT BLUE CLAY	181'	196'
WHITE COARSE SAND	196'	234'


RECEIVED
MAY 1 1977

DRILLERS REMARKS:

MISS. BD. OF WATER COMM.

If well telescopes please
sketch and show depths.

GROUND LEVEL

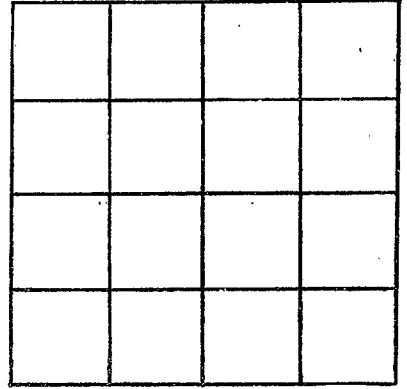

SECTION _____

Please indicate well location X.

ADDITIONAL INFORMATION

If more than one screen,
show locations of each on sketch.