

NEWTON
M 2008
3-29-77

MISSISSIPPI
BOARD OF WATER COMMISSIONERS
 416 North State Street
 Jackson, Mississippi 39201

WATER WELL DRILLERS LOG

3-29-77 ^{13P} McDonald & Hill Newton
 date well completed firm name county well located


LANDOWNER:	description of formations encountered	from	to
Pat Barber Chunky (mailing address)			
WELL LOCATION:	shale	16	24
sec. <u>13</u> T. <u>6</u> N. R. <u>13</u> E. S. W.	St Rock sand & shale	24	45
* <u>2</u> miles <u>N</u> of <u>Chunky</u> (distance) (direction) (nearest town)	Shale St Rock	45	62
WELL PURPOSE: (home, irrigation, municipal, industrial)	Rock	62	64
WELL COMPLETION DATA:	shale st Rock	64	165
(1) diameter (inches) <u>4"</u>	sand	165	200
(2) total depth (feet) <u>200'</u>			
(3) static water level (feet) <u>156'</u> below top of ground.			
(4) casing <u>PVC</u> , <u>50'</u> , (material) (depth) <u>4"</u> if telescope see back. (size)			
(5) screen _____, (length) (depth to top) _____, _____ (size) (material)			
(6) pump <u>1/2</u> <u>6 gpm</u> (HP) (yield gpm) <u>E</u> (type power)			
(7) electric log _____ (yes or no) _____ (organization running log)			
(8) how well bottom plugged <u>open</u>			
DRILLERS REMARKS: <u>set pump 150'</u>			

RECEIVED
 APR 4 1977

MISS. BD. OF WATER COMMISSIONERS

If well telescopes please
sketch and show depths.

GROUND LEVEL

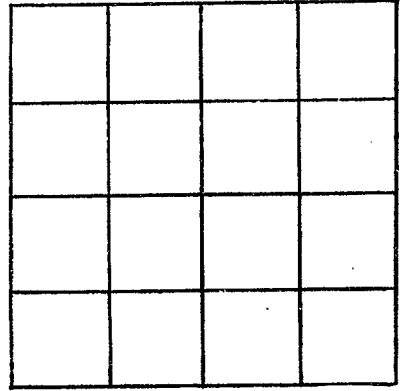

SECTION _____

Please indicate well location X.

ADDITIONAL INFORMATION

If more than one screen,
show locations of each on sketch.