

NEWTON
M 2009
4-1-77

MISSISSIPPI
BOARD OF WATER COMMISSIONERS
416 North State Street
Jackson, Mississippi 39201

WATER WELL DRILLERS LOG

4-1-77^{13P} date well completed McDonald + Hill firm name Newton county well located

LANDOWNER:
A. T. Embrey
Cheney
(mailing address)

WELL LOCATION:
sec. 26 T. 6 N R. 13 E
1 miles west of Cheney
(distance) (direction) (nearest town)

WELL PURPOSE:
(home, irrigation, municipal, industrial)

WELL COMPLETION DATA:

(1) diameter (inches) 4"

(2) total depth (feet) 200'

(3) static water level (feet) 57' below top of ground.

(4) casing PVC 85' (material) (depth)
4" (size) if telescope see back.

(5) screen (length) (depth to top) (size) (material)

(6) pump 34 50 P.M. (HP) (yield gpm)
E (type power)

(7) electric log (yes or no)
(organization running log)

(8) how well bottom plugged open

description of formations encountered	from	to
clay	0	10
sand	10	40
shal. st. rock	40	90
rock + shale	90	170
sand	170	200

RECEIVED


APR 11 1977

MISS. BD. OF WATER COMM

DRILLERS REMARKS:

If well telescopes please sketch and show depths.

GROUND LEVEL

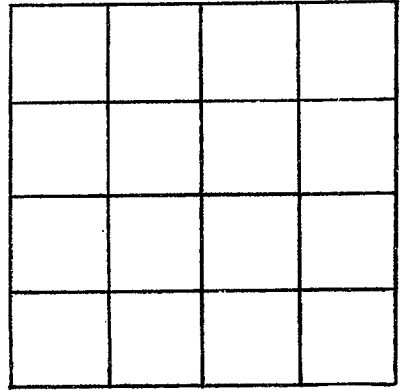

SECTION _____

Please indicate well location X.

ADDITIONAL INFORMATION

If more than one screen,
show locations of each on sketch.