

NEWTON
M 2010
5-2-77

MISSISSIPPI
 BOARD OF WATER COMMISSIONERS
 416 North State Street
 Jackson, Mississippi 39201

WATER WELL DRILLERS LOG


5-2-77 ^{13A} Mr Donald + Hill Newton
 date well completed firm name county well located

LANDOWNER:	description of formations encountered	from	to
<u>Union Primitive Church</u>	<u>Clay</u>	<u>0</u>	<u>16</u>
<u>Chanby</u> (mailing address)	<u>Shale</u>	<u>16</u>	<u>30</u>
WELL LOCATION: sec <u>27</u> T <u>6</u> N R <u>13</u> E <u>9</u> miles <u>SW</u> of <u>Chanby</u> (distance) (direction) (nearest town)	<u>Rock + shells</u>	<u>30</u>	<u>55</u>
WELL PURPOSE: <u>domestic</u> (home, irrigation, municipal, industrial)	<u>st sand + shells</u>	<u>55</u>	<u>63</u>
WELL COMPLETION DATA:	<u>Shale + Rock</u>	<u>63</u>	<u>190</u>
(1) diameter (inches) <u>11"</u>	<u>sand</u>	<u>190</u>	<u>220</u>
(2) total depth (feet) <u>220'</u>			
(3) static water level (feet) <u>38'</u> below top of ground.			
(4) casing <u>PVC</u> , <u>2 1/2'</u> (material), (depth)			
<u>4</u> if telescope see back. (size)			
(5) screen (length) (depth to top)			
(size) (material)			
(6) pump <u>1/2</u> <u>59 GPM</u> (HP) (yield gpm)			
<u>E</u> (type power)			
(7) electric log (yes or no)			
(organization running log)			
(8) how well bottom plugged <u>open</u>			
DRILLERS REMARKS:			

RECEIVED
 MAY 9 - 1977
 MISSISSIPPI WATER BOARD

If well telescopes please
sketch and show depths.

GROUND LEVEL

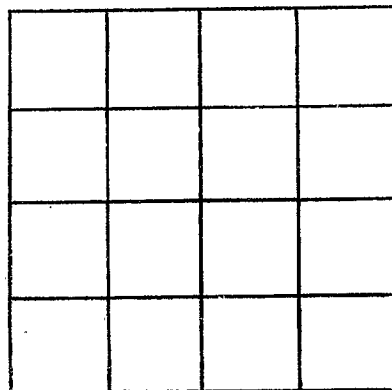

SECTION _____

Please indicate well location X.

ADDITIONAL INFORMATION

If more than one screen,
show locations of each on sketch.