

NEWTON  
M 2011  
5-10-77

MISSISSIPPI  
 BOARD OF WATER COMMISSIONERS  
 416 North State Street  
 Jackson, Mississippi 39201

WATER WELL DRILLERS LOG

5-18-77 <sup>13P</sup> McDonald & Hill Newton  
 date well completed firm name county well located

LANDOWNER:  
Clay Cooley  
Rt #1 Hickory  
 (mailing address)

WELL LOCATION:  
 sec. 22 T 6 N R. 13 E  
2 miles NW of Chumb  
 (distance) (direction) (nearest town)

WELL PURPOSE:  
 (home, irrigation, municipal, industrial)

WELL COMPLETION DATA:

- (1) diameter (inches) 4"
- (2) total depth (feet) 200'
- (3) static water level (feet) 63' below above top of ground.
- (4) casing PVC, 23" #160  
 (material) (depth)  
4" if telescope see back.  
 (size)
- (5) screen \_\_\_\_\_  
 (length) (depth to top)  
 \_\_\_\_\_  
 (size) (material)
- (6) pump 1/2 50 gpm  
 (HP) (yield/gpm)  
E  
 (type power)
- (7) electric log \_\_\_\_\_  
 (yes or no)  
 \_\_\_\_\_  
 (organization running log)
- (8) how well bottom plugged Open

description of formations encountered	from	to
<u>clay &amp; sand</u>	<u>0</u>	<u>20</u>
<u>shale</u>	<u>20</u>	<u>25</u>
<u>rock + shale</u>	<u>25</u>	<u>47</u>
<u>green sand</u>	<u>47</u>	<u>52</u>
<u>shale &amp; rock</u>	<u>52</u>	<u>175</u>
<u>sand</u>	<u>175</u>	<u>200</u>

**RECEIVED**


MAY 16 1977

DRILLERS REMARKS:

MISS. BD. OF WATER COMMISSIONERS

If well telescopes please  
sketch and show depths.

GROUND LEVEL

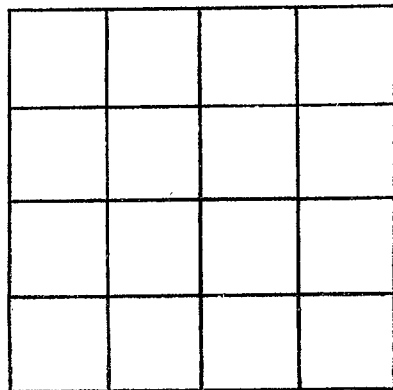

SECTION \_\_\_\_\_

Please indicate well location X.

ADDITIONAL INFORMATION

If more than one screen,  
show locations of each on sketch.