

NEWTON
M 2012
5-16-77

MISSISSIPPI
 BOARD OF WATER COMMISSIONERS
 416 North State Street
 Jackson, Mississippi 39201

WATER WELL DRILLERS LOG

5-16-77 ^{13P} McDonald + Hill Newton
 date well completed firm name county well located

LANDOWNER:

John Graybeal
Rt 1 Chubb
 (mailing address)

description of formations encountered

from to

<u>clay + sand</u>	<u>0</u>	<u>20</u>
<u>shale</u>	<u>20</u>	<u>40</u>
<u>Rock + shale</u>	<u>40</u>	<u>55</u>
<u>green, sandy, sandy shale</u>	<u>55</u>	<u>64</u>
<u>Rock + shale</u>	<u>64</u>	<u>180</u>
<u>sand</u>	<u>180</u>	<u>200</u>

WELL LOCATION:

sec. 24 T. 6 (N) R. 13 E
2 miles N of Chubb
 (distance) (direction) (nearest town)

WELL PURPOSE: none
 (home, irrigation, municipal, industrial)

WELL COMPLETION DATA:

- (1) diameter (inches) 4"
- (2) total depth (feet) 200'
- (3) static water level (feet) 140' below top of ground.
- (4) casing PVC, 3.5'
 (material) (depth)
4"
 (size) if telescope see back.
- (5) screen —, —
 (length) (depth to top)
— (size) (material)
- (6) pump 1/2, 50 GPM
 (HP) (yield gpm)
E
 (type power)
- (7) electric log —
 (yes or no)
—
 (organization running log)
- (8) how well bottom plugged open


DRILLERS REMARKS:

RECEIVED
 MAY 23 1977

MISS. BR. OF WATER COMMISSIONERS

If well telescopes please sketch and show depths.

GROUND LEVEL

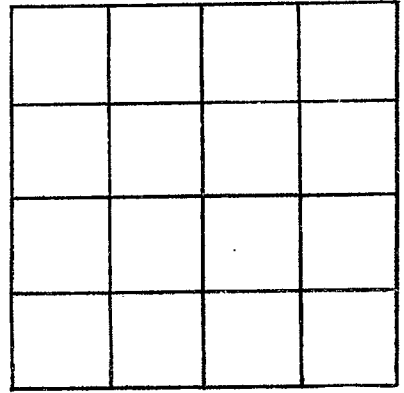

SECTION _____

Please indicate well location X.

ADDITIONAL INFORMATION

If more than one screen,
show locations of each on sketch.