

NEWTON
M 2013
8-18-77

MISSISSIPPI
 BOARD OF WATER COMMISSIONERS
 416 North State Street
 Jackson, Mississippi 39201

WATER WELL DRILLERS LOG

8-18-77 13P 19 McDonald & Hill Newton
 date well completed firm name county well located


LANDOWNER:	description of formations encountered	from	to
David Cleveland	clay + sand	0	10
Hickory (mailing address)	sand	10	45
WELL LOCATION:	sandy shale	45	65
sec. 33 T. 6 N R. 13 E 3 miles E of Hickory (distance) (direction) (nearest town)	shale	65	90
WELL PURPOSE: home (home, irrigation, municipal, industrial)	Rock + shells	90	115
WELL COMPLETION DATA:	green sand + sandy shale	115	125
(1) diameter (inches) 4"	shale + Rock	125	140
(2) total depth (feet) 560'	sandy + sandy shale	140	150
(3) static water level (feet) 40' below top of ground.	shale + Rock	150	235
(4) casing POC 82' (material) (depth) 4" if telescope see back. (size)	sandy shale + sand	235	245
(5) screen (length) (depth to top) (size) (material)	sand	245	260
(6) pump 1/2 5 gpm (HP) (yield gpm) F (type power)			
(7) electric log (yes or no) (organization running log)			
(8) how well bottom plugged open			
DRILLERS REMARKS:			

RECEIVED
 AUG 22 1977

MISS. BOARD OF WATER COMMISSIONERS

If well telescopes please sketch and show depths.

GROUND LEVEL

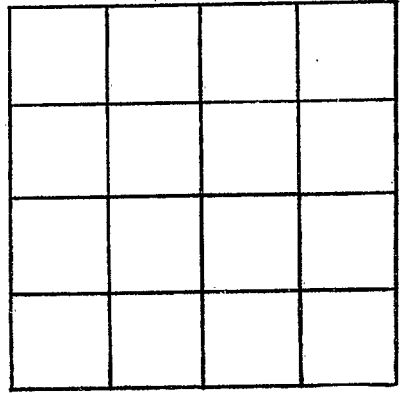

SECTION _____

Please indicate well location X.

ADDITIONAL INFORMATION

If more than one screen,
show locations of each on sketch.