

NEWTON
 M 214
 11/15/77

MISSISSIPPI
 BOARD OF WATER COMMISSIONERS
 416 North State Street
 Jackson, Mississippi 39201

WATER WELL DRILLERS LOG

11-15-77 date well completed 19 Williamson Drilling Co. firm name Newton county well located

LANDOWNER: Myrtle Kirby
Chambers Mrs
 (mailing address)

description of formations encountered	from	to
top soil	0	3
blue clay	3	10
sand	10	13
crack clay	13	105
sand	105	140

WELL LOCATION:
 sec. 26 T 6 N R. 13 E
inside of Chambers
 (distance) miles (direction) (nearest town)

WELL PURPOSE: Home
 (home, irrigation, municipal, industrial)

- WELL COMPLETION DATA:
- (1) diameter (inches) 4
 - (2) total depth (feet) 140
 - (3) static water level (feet) 20 below above top of ground.
 - (4) casing PVC (material) 140 (depth)
4 (size) if telescope see back.
 - (5) screen no (length) (depth to top)
 (size) (material)
 - (6) pump 1 (HP) 12 (yield gpm)
Electric (type power)
 - (7) electric log no (yes or no)
no (organization running log)
 - (8) how well bottom plugged open


DRILLERS REMARKS:

RECEIVED
 APR 10 1978

MISS. BD. OF WATER COMMISSIONERS

If well telescopes please sketch and show depths.

GROUND LEVEL

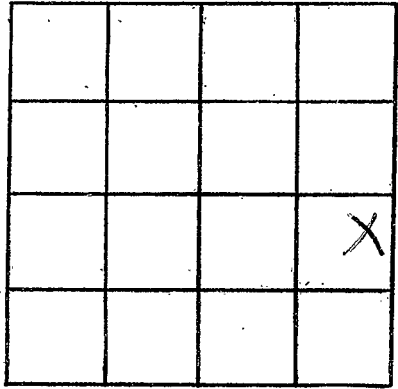

SECTION 26

Please indicate well location X.

ADDITIONAL INFORMATION

A series of horizontal lines for writing additional information.

If more than one screen, show locations of each on sketch.