

Newton  
 M 2015  
 11/30/77

MISSISSIPPI  
 BOARD OF WATER COMMISSIONERS  
 416 North State Street  
 Jackson, Mississippi 39201

WATER WELL DRILLERS LOG

11-30-77, McDonald & Well Newton  
 date well completed firm name county well located

LANDOWNER:  
 Robert Lew  
 R. F. / Hickory  
 (mailing address)

description of formations encountered	from	to
sand & clay	0	18
sandy shale	18	40
shale	40	70
Rock & shells	70	96
cross sand & sand shale	96	105

WELL LOCATION:  
 sec 20 T-6 R. 13 E  
 4 miles NE of Hickory  
 (distance) (direction) (nearest town)

WELL PURPOSE: none  
 (home, irrigation, municipal, industrial)

- WELL COMPLETION DATA:
- (1) diameter (inches) 4"
  - (2) total depth (feet) 240'
  - (3) static water level (feet) 58' below top of ground.
  - (4) casing PVC, 66' (material) (depth)  
 4" (size) If telescope see back.
  - (5) screen (length) (depth to top)  
 (size) (material)
  - (6) pump 1/2 (HP) 60.00 (yield gpm)  
 F (type power)
  - (7) electric log (yes or no)  
 (organization running log)
  - (8) how well bottom plugged open

shale & rock	105	225
sand	225	240


RECEIVED  
 DEC 6 1977

MISS. BD. OF WATER COMM

DRILLERS REMARKS:

If well telescopes please sketch and show depths.

GROUND LEVEL

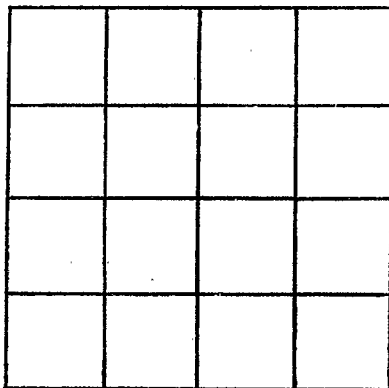

SECTION \_\_\_\_\_

Please indicate well location X.

ADDITIONAL INFORMATION

If more than one screen, show locations of each on sketch.