

NEWTON

M 2016

12-15-77

MISSISSIPPI BOARD OF WATER COMMISSIONERS
416 North State Street
Jackson, Mississippi 39201

WATER WELL DRILLERS LOG

12-15-77
date well completed

1977 Williamson Drilling Co.
firm name

Newton
county well located

LANDOWNER: J. Archie
At 1 Box 113A
Chucky Ins.
(mailing address)

description of formations encountered	from	to
top soil	0	3
red clay	3	10
red sand	10	32
rock + clay	32	190
blue clay	190	227
sand	227	263

WELL LOCATION:
sec. 4 T. 6 N R. 13 E
S W
6 miles N.W. of Chucky
(distance) (direction) (nearest town)

WELL PURPOSE: Home
(home, irrigation, municipal, industrial)

WELL COMPLETION DATA:

- (1) diameter (inches) 4
- (2) total depth (feet) 263
- (3) static water level (feet) 170 below top of ground.
- (4) casing PVC 220 (material) (depth)
- 4 (size) If telescope see back.
- (5) screen no (length) (depth to top)
- (size) (material)
- (6) pump 1/2 (HP) 8 (yield gpm)
- Electric (type power)
- (7) electric log No (yes or no)
- no (organization running log)
- (8) how well bottom plugged open


DRILLERS REMARKS:

RECEIVED
MAY 12 1978

MISS. BD. OF WATER COMM.

If well telescopes please sketch and show depths.

GROUND LEVEL

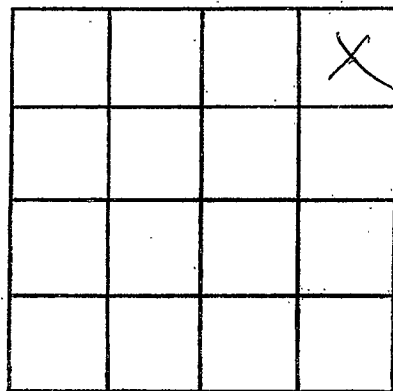

SECTION 4

Please indicate well location X.

ADDITIONAL INFORMATION

If more than one screen,
show locations of each on sketch.