

Newton
M 207
3/1/78

MISSISSIPPI
BOARD OF WATER COMMISSIONERS
416 North State Street
Jackson, Mississippi 39201

WATER WELL DRILLERS LOG

3-1-78 19 date well completed
McDonald + Hill firm name
Newton county well located

LANDOWNER:
Julian Richardson
P.O. # / Chunky
(mailing address)

WELL LOCATION:
sec. 23 T-60 N R-13 E
2 miles N of Chunky
(distance) (direction) (nearest town)

WELL PURPOSE: home
(home, irrigation, municipal, industrial)

- WELL COMPLETION DATA:
- (1) diameter (inches) 4"
 - (2) total depth (feet) 210'
 - (3) static water level (feet) 140' below top of ground.
 - (4) casing pvc 40' rock 160'
(material) (depth)
4" if telescope see back.
(size)
 - (5) screen (length) (depth to top)
(size) (material)
 - (6) pump 3 1/2 HP 69 gpm
(HP) (yield gpm)
E (type power)
 - (7) electric log (yes or no)
(organization running log)
 - (8) how well bottom plugged open

description of formations encountered	from	to
sand & clay	0	25
shale	25	42
rock & shale	42	60
green sand	60	65
shale & rocks	65	185
sand	185	210


DRILLERS REMARKS:

RECEIVED
MAR - 6 1978

MISS. BD. OF WATER COMM.

If well telescopes please
sketch and show depths.

GROUND LEVEL

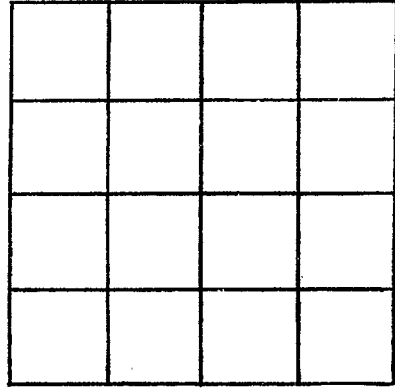

SECTION _____

Please indicate well location X.

ADDITIONAL INFORMATION

If more than one screen,
show locations of each on sketch.