

NEWTON

M 218

9-20-78

MISSISSIPPI BOARD OF WATER COMMISSIONERS 416 North State Street Jackson, Mississippi 39201

WATER WELL DRILLERS LOG

9-20-78 date well completed Williamson Drilling Co. firm name Newton county well located

LANDOWNER: George T. Pearson Chumby, Mrs. (mailing address)


Table with 3 columns: description of formations encountered, from, to. Entries: red clay (0-9), blue clay (9-98), rock & clay (98-142), sand (142-210)

WELL LOCATION: sec 1 T 6 N R 13 E 3 miles N.W. of Chumby (distance) (direction) (nearest town)

WELL PURPOSE: Home (home, irrigation, municipal, industrial)

- WELL COMPLETION DATA: (1) diameter (inches) 4 (2) total depth (feet) 210 (3) static water level (feet) 50 below top of ground. (4) casing PVC 87 (material) (depth) 1/2 (size) If telescope see back. (5) screen no (length) (depth to top) (size) (material) (6) pump 1 (HP) 19 (yield gpm) Electric (type power) (7) electric log no (yes or no) (organization running log) (8) how well bottom plugged open


DRILLERS REMARKS:

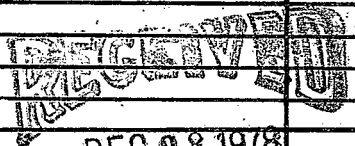

MISS. BD. OF WATER COMMISSIONERS

If well telescopes please sketch and show depths.

GROUND LEVEL

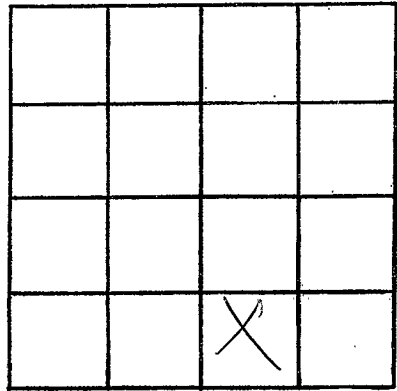

SECTION 21

Please indicate well location X.

ADDITIONAL INFORMATION

If more than one screen,
show locations of each on sketch.