

NEWTON
M 2019
3-28-79

MISSISSIPPI
BOARD OF WATER COMMISSIONERS
416 North State Street
Jackson, Mississippi 39201

WATER WELL DRILLERS LOG

3-21-79 date well completed
McDonald & Bell firm name
Newton county well located

LANDOWNER:	description of formations encountered	from	to
Tom Pearson	clay	0	17
Rt # 1 chunky (mailing address)	shale	17	30
WELL LOCATION: sec 27 T 6 N R 13 E 2 miles NW of Chunky (distance) (direction) (nearest town)	Rock & shells	30	55
WELL PURPOSE: none (home, irrigation, municipal, industrial)	green sand	55	61
WELL COMPLETION DATA: (1) diameter (inches) 4" (2) total depth (feet) 220' (3) static water level (feet) 55' below top of ground. (4) casing PUC 27" (material) (depth) 4" if telescope see back. (size) (5) screen (length) (depth to top) (size) (material) (6) pump 34 b.c.o.m. (HP) (yield gpm) F (type power) (7) electric log (yes or no) (organization running log) (8) how well bottom plugged Open	shale & RDRP sand	61	190
DRILLERS REMARKS:		190	220


Miss. Board of Water Comm.

MAR 27 1979

RECEIVED

If well telescopes please sketch and show depths.

GROUND LEVEL

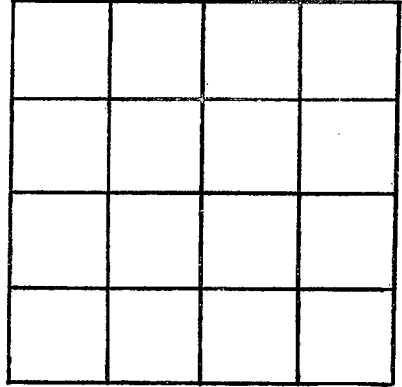

SECTION _____

Please indicate well location X.

ADDITIONAL INFORMATION

If more than one screen,
show locations of each on sketch.