

Newton  
M 2020

MISSISSIPPI  
BOARD OF WATER COMMISSIONERS  
416 North State Street  
Jackson, Mississippi 39201

WATER WELL DRILLERS LOG

3-7-79  
3-7-79 date well completed  
Williamson Drilling Co. firm name  
Newton county well located

LANDOWNER: Fried gold  
Chambers Wis.  
(mailing address)

description of formations encountered	from	to
Top soil	0	2
sand	2	18
Rock & Clay	18	135
sand	135	168

WELL LOCATION:  
sec 15 T 60 N R 13 E  
1/4 miles north of Chambers  
(distance) (direction) (nearest town)

WELL PURPOSE: Home  
(home, irrigation, municipal, industrial)

- WELL COMPLETION DATA:
- (1) diameter (inches) 4
  - (2) total depth (feet) 168
  - (3) static water level (feet) 38 below top of ground.
  - (4) casing PVC 53 (material) (depth)  
4 (size) if telescope see back.
  - (5) screen No (length) (depth to top)
  - (6) pump 12 (HP) (yield gpm)  
Electric (type power)
  - (7) electric log No (yes or no)  
No (organization running log)
  - (8) how well bottom plugged open

DRILLERS REMARKS:


Miss. Board of Water Comm.

APR 1 - 1979

RECEIVED

If well telescopes please sketch and show depths.

GROUND LEVEL

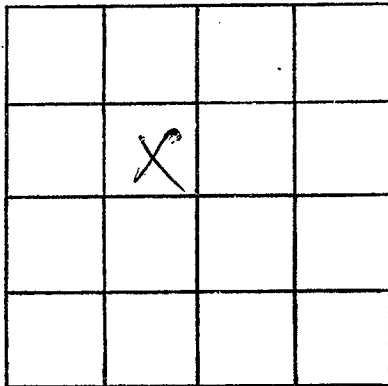

SECTION 15

Please indicate well location X.

ADDITIONAL INFORMATION

If more than one screen, show locations of each on sketch.