

NEWTON
M 2021
3-28-79

MISSISSIPPI
BOARD OF WATER COMMISSIONERS
416 North State Street
Jackson, Mississippi 39201

WATER WELL DRILLERS LOG

3-20-79 date well completed
McDonald & Hill firm name
Newton county well located

LANDOWNER:	description of formations encountered	from	to
Lexie Branch	clay	0	10
RD #1 Box 114A, Hickory (mailing address)	shale	10	15
WELL LOCATION: sec. 33 T. 6 N R. 13 E 2 miles S E of Hickory (distance) (direction) (nearest town)	Rock & shells	15	42
	shale & rock	42	160
WELL PURPOSE: Home (home, irrigation, municipal, industrial)	sandy shale	160	180
WELL COMPLETION DATA:	sandy shale	180	200
(1) diameter (inches) 2'	course sand	210	210
(2) total depth (feet) 210'			
(3) static water level (feet) 3' below top of ground.			
(4) casing PVC 205' (material) (depth) 2' (size) if telescope see back.			
(5) screen 5' 215' to 210' (length) (depth to top) 3" PVC (size) (material)			
(6) pump 1/2 HP 6000 (HP) (yield gpm) E (type power)			
(7) electric log (yes or no) (organization running log)			
(8) how well bottom plugged valve			
DRILLERS REMARKS:			


Miss. Board of Water Comm.

MAR 27 1979

RECEIVED

If well telescopes please sketch and show depths.

GROUND LEVEL

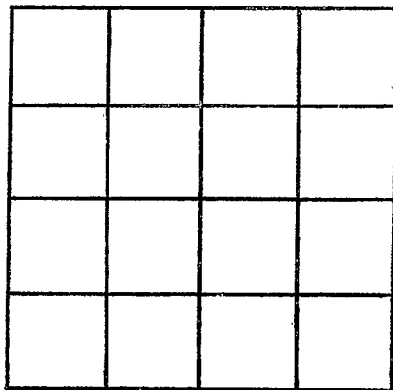

SECTION _____

Please indicate well location X.

ADDITIONAL INFORMATION

If more than one screen,
show locations of each on sketch.