

NEWTON

M 2022

5-30-79

MISSISSIPPI
 BOARD OF WATER COMMISSIONERS
 416 North State Street
 Jackson, Mississippi 39201

WATER WELL DRILLERS LOG

5-30-79
date well completed

McDonald & Hill
firm name

Newton
county well located

LANDOWNER:

Leland Cavalell

Rt # 1 Chunky
(mailing address)

description of formations encountered

sand

from 0 to 30

shale

30 52

pink & sh. lls & green sand

52 80

shale & rock

80 200

sand

200 240

WELL LOCATION:

sec 1 T 6 N R 13 E
3 miles N of Chunky
(distance) (direction) (nearest town)

WELL PURPOSE: home
(home, irrigation, municipal, industrial)

WELL COMPLETION DATA:

- (1) diameter (inches) 4"
- (2) total depth (feet) 240'
- (3) static water level (feet) 95' below top of ground.
- (4) casing PVC, 4 1/2"
(material) (depth)
4" (size) If telescope see back.
- (5) screen (length) (depth to top)
(size) (material)
- (6) pump 3/4 HP, 600 gpm
(HP) (well gpm)
E (type power)
- (7) electric log (yes or no)
(organization running log)
- (8) how well bottom plugged Open

Miss. Board of Water Comm.


JUN 6 1979

DRILLERS REMARKS:

RECEIVED

If well telescopes please
sketch and show depths.

GROUND LEVEL

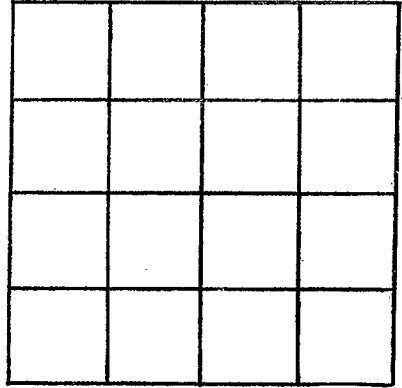

SECTION _____

Please indicate well location X.

ADDITIONAL INFORMATION

If more than one screen,
show locations of each on sketch.