

NEWTON

M 2023

6-1-79

**MISSISSIPPI
BOARD OF WATER COMMISSIONERS
416 North State Street
Jackson, Mississippi 39201**

WATER WELL DRILLERS LOG

6-1-79

date well completed

Williamson Drilling Co.

firm name

Newton

county well located

LANDOWNER: Morris Hannon

Rt 1 Box 4A

Chumley

(mailing address)

description of formations encountered

from

to

top soil

0

2

red clay

2

8

blue clay

8

24

sand

24

45

dark clay

25

82

sand

82

105

WELL LOCATION:

sec 36 T-6 N R-13 E ?

1 miles East Newton
(distance) (direction) (nearest town)

WELL PURPOSE: Home

(home, irrigation, municipal, industrial)

WELL COMPLETION DATA:

(1) diameter (inches) **4**

(2) total depth (feet) **105**

(3) static water level (feet) **80** below above top of ground.

(4) casing **PVC** **51**
(material) (depth)

4 If telescope see back.
(size)

(5) screen **no**
(length) (depth to top)

(size) (material)

(6) pump **1/2** **12**
(HP) (yield gpm)

Electric
(type power)

(7) electric log **no**
(yes or no)

no
(organization running log)

(8) how well bottom plugged **open**

DRILLERS REMARKS:


Miss. Board of Water Comm.

JUN 12 1979

RECEIVED

If well telescopes please
sketch and show depths.

GROUND LEVEL

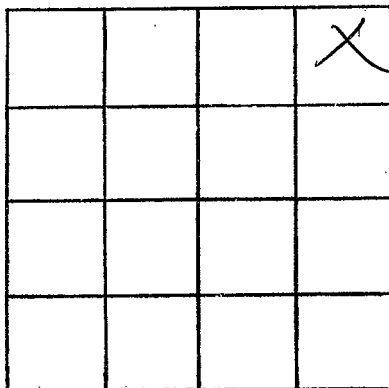

SECTION 36

Please indicate well location X.

ADDITIONAL INFORMATION

If more than one screen,
show locations of each on sketch.