

NEWTON  
M 2024  
7-12-79

MISSISSIPPI  
 BOARD OF WATER COMMISSIONERS  
 416 North State Street  
 Jackson, Mississippi 39201

WATER WELL DRILLERS LOG


7-12-79 19 McDonald's Well Newton  
 date well completed firm name county well located

LANDOWNER:	description of formations encountered	from	to
<u>Mary A. Wilho</u>	<u>clay + sand</u>	<u>0</u>	<u>10</u>
<u>Rt # 1 Box 152A, Hokeny</u> (mailing address)	<u>sand</u>	<u>10</u>	<u>80</u>
WELL LOCATION: sec <u>30</u> T <u>6</u> <u>N</u> R <u>13</u> <u>E</u> <u>2</u> miles <u>N</u> of <u>Hokeny</u> (distance) (direction) (nearest town)	<u>sandy shale</u>	<u>80</u>	<u>100</u>
	<u>shale</u>	<u>100</u>	<u>130</u>
WELL PURPOSE: <u>home</u> (home, irrigation, municipal, industrial)	<u>Rock + shells</u>	<u>130</u>	<u>160</u>
WELL COMPLETION DATA:	<u>green sand + sandy shale</u>	<u>160</u>	<u>170</u>
(1) diameter (inches) <u>4"</u>	<u>shale + rock</u>	<u>170</u>	<u>280</u>
(2) total depth (feet) <u>300'</u>	<u>sandy shale</u>	<u>280</u>	<u>295</u>
(3) static water level (feet) <u>60'</u> below top of ground.	<u>course to Med. sand</u>	<u>295</u>	<u>300</u>
(4) casing <u>PVC</u> , <u>125'</u> (material) (depth) <u>4"</u> (size) if telescope see back.			
(5) screen _____ (length) (depth to top) _____ (size) (material)			
(6) pump <u>1/2</u> <u>8 gpm</u> (HP) (yield gpm) <u>F</u> (type power)			
(7) electric log _____ (yes or no) _____ (organization running log)			
(8) how well bottom plugged <u>open</u>			
DRILLERS REMARKS:			

Miss. Board of Water Comm.  
 JUL 16 1979  
 RECEIVED

If well telescopes please sketch and show depths.

GROUND LEVEL

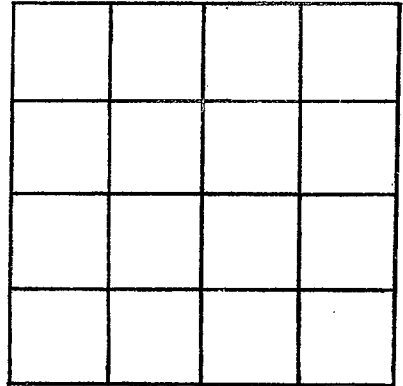

SECTION \_\_\_\_\_

Please indicate well location X.

ADDITIONAL INFORMATION

If more than one screen, show locations of each on sketch.