

NEWTON
 M 2025
 8-24-79

MISSISSIPPI
 BOARD OF WATER COMMISSIONERS
 416 North State Street
 Jackson, Mississippi 39201

WATER WELL DRILLERS LOG

8-24 1979 McDonald & Hill Inc Newton
 date well completed firm name county well located

LANDOWNER: Harris Caldwell
 Rt # 1
 Hickory, Miss
 (mailing address)

WELL LOCATION:
 sec. 19 T. 6 N. R. 13 E.
 S W
 5 miles N.E. of Hickory
 (distance) (direction) (nearest town)

WELL PURPOSE: home
 (home, irrigation, municipal, industrial)

WELL COMPLETION DATA:

(1) diameter (inches) 4

(2) total depth (feet) 250

(3) static water level (feet) 60 below above top of ground.

(4) casing 4" PVC 62 (material) (depth)

no (size) if telescope see back.

(5) screen no (length) (depth to top)

(size) (material)

(6) pump 10 (HP) (yield gpm)

(type power)

(7) electric log no (yes or no)

(organization running log)

(8) how well bottom plugged open

description of formations encountered	from	to
Clay + sand	0	20
Shale, sandyst	20	40
Shale	40	68
St green sand + Rock	68	105
Rock + shale	105	139
Sand	139	142
Rock + shale	142	228
st fine sand	228	240
course sand	240	250

Miss. Board of Water Comm.


SEP - 4 1979

RECEIVED

DRILLERS REMARKS: none

If well telescopes please sketch and show depths.

GROUND LEVEL

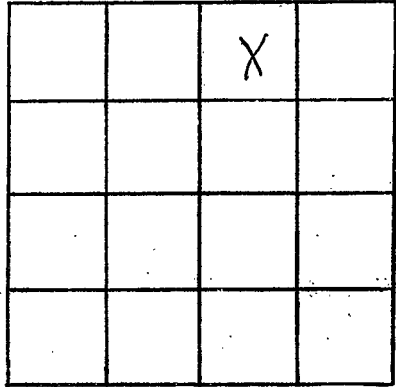

SECTION 19

Please indicate well location X.

ADDITIONAL INFORMATION

If more than one screen, show locations of each on sketch.