

NEWTON
M 2026
8/17/79

MISSISSIPPI
BOARD OF WATER COMMISSIONERS
416 North State Street
Jackson, Mississippi 39201

WATER WELL DRILLERS LOG


8-17-79 date well completed McDonald's Well firm name Newton county well located

LANDOWNER:	description of formations encountered	from	to
Wilbur Grantham	sandal st clay	0	32
Rt #1 Box 101A, Cheney (mailing address)	sandy shale	32	40
	shale	40	64
	Rock & shells	64	89
	green sand	89	93
	Rock & shale	93	215
	sandal	215	240
WELL LOCATION: sec <u>22</u> T. <u>6</u> N R. <u>13</u> E <u>3</u> miles <u>N.W</u> of <u>Cheney</u> (distance) (direction) (nearest town)			
WELL PURPOSE: <u>home</u> (home, irrigation, municipal, industrial)			
WELL COMPLETION DATA:			
(1) diameter (inches) <u>4"</u>			
(2) total depth (feet) <u>240'</u>			
(3) static water level (feet) <u>104'</u> below top of ground.			
(4) casing <u>PVC</u> (<u>600'</u>) (material) (depth) <u>4"</u> (size) if telescope see back.			
(5) screen _____ (length) _____ (depth to top) (size) _____ (material)			
(6) pump <u>1/2</u> (<u>HP</u>) <u>109.0 M</u> (y/d/gpm) <u>A</u> (type power)			
(7) electric log _____ (yes or no) (organization running log)			
(8) how well bottom plugged <u>open</u>			
DRILLERS REMARKS:			

Miss. Board of Water Comm.
AUG 22 1979
RECEIVED

If well telescopes please sketch and show depths.

GROUND LEVEL

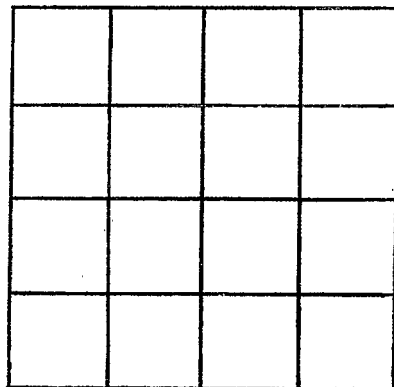

SECTION _____

Please indicate well location X.

ADDITIONAL INFORMATION

If more than one screen, show locations of each on sketch.