

Newton
M 207

MISSISSIPPI
BOARD OF WATER COMMISSIONERS
416 North State Street
Jackson, Mississippi 39201

WATER WELL DRILLERS LOG

11-6-79
11-6-79 19 McDonald & Hill Newton
date well completed firm name county well located

LANDOWNER:	description of formations encountered	from	to
B. H. Johnson	clay & sand	0	25
Rt # 1 Hickory (mailing address)	sandy shale	25	30
WELL LOCATION: sec. 3/T 6 N R. 13 E 1/2 miles S E of Hickory (distance) (direction) (nearest town)	shale	30	52
WELL PURPOSE: <u>home</u> (home, irrigation, municipal, industrial)	Rock & shells	52	75
WELL COMPLETION DATA: (1) diameter (inches) 4"	green sand	75	82
(2) total depth (feet) 240'	shale + Rock	82	200
(3) static water level (feet) 30' below top of ground.	sandy shale	200	210
(4) casing PUC 50' (material) (depth) 4" If telescope see back. (size)	sand	210	240
(5) screen (length) (depth to top) (size) (material)			
(6) pump 3U 109 RPM (HP) (yield gpm) F (type power)			
(7) electric log (yes or no) (organization running log)			
(8) how well bottom plugged <u>SPND</u>			
DRILLERS REMARKS:			


DEPT. OF NATURAL RESOURCES
BUREAU OF LAND & WATER RESOURCES

NOV 13 1979

RECEIVED

If well telescopes please sketch and show depths.

GROUND LEVEL

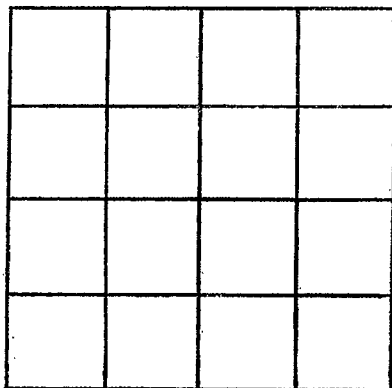

SECTION _____

Please indicate well location X.

ADDITIONAL INFORMATION

If more than one screen, show locations of each on sketch.