

Newton  
MS 2028

MISSISSIPPI  
BOARD OF WATER COMMISSIONERS  
416 North State Street  
Jackson, Mississippi 39201

10-31-79  
10-31-79 19

WATER WELL DRILLERS LOG

McDonald & Hill Newton  
firm name county well located

LANDOWNER:	description of formations encountered	from	to
<u>R. B. Toil</u>	<u>sand &amp; clay</u>	<u>0</u>	<u>25</u>
<u>Mapon</u> (mailing address)	<u>dark shale</u>	<u>25</u>	<u>40</u>
WELL LOCATION: sec. <u>31</u> T. <u>6</u> N. R. <u>13</u> E. <u>1</u> miles <u>E</u> of <u>Mapon</u> (distance) (direction) (nearest town)	<u>shale</u>	<u>40</u>	<u>68</u>
WELL PURPOSE: <u>home</u> (home, irrigation, municipal, industrial)	<u>Rock &amp; shells</u>	<u>68</u>	<u>94</u>
WELL COMPLETION DATA: (1) diameter (inches) <u>4"</u>	<u>greensand</u>	<u>94</u>	<u>103</u>
(2) total depth (feet) <u>240'</u>	<u>Rock &amp; shale</u>	<u>103</u>	<u>220</u>
(3) static water level (feet) <u>15'</u> below above top of ground.	<u>sand, shale &amp; silt</u>	<u>220</u>	<u>230</u>
(4) casing <u>PVC, 66'</u> (material) (depth) <u>4"</u> if telescope see back. (size)	<u>sand</u>	<u>230</u>	<u>240</u>
(5) screen _____ (length) (depth to top) (size) (material)			
(6) pump <u>1/2</u> <u>10 gpm</u> (HP) (yield gpm) <u>F</u> (type power)			
(7) electric log _____ (yes or no) (organization running log)			
(8) how well bottom plugged <u>open</u>			
DRILLERS REMARKS:			


DEPT. OF NATURAL RESOURCES  
BUREAU OF LAND & WATER RESOURCES

NOV - 5 1979

RECEIVED

If well telescopes please sketch and show depths.

GROUND LEVEL

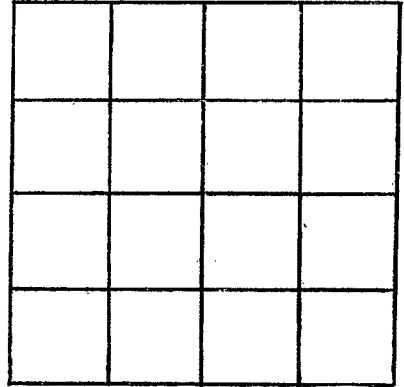

SECTION \_\_\_\_\_

Please indicate well location X.

ADDITIONAL INFORMATION

If more than one screen,  
show locations of each on sketch.