

NEWTON  
M 2029  
7-13-79

MISSISSIPPI  
 BOARD OF WATER COMMISSIONERS  
 416 North State Street  
 Jackson, Mississippi 39201

WATER WELL DRILLERS LOG

7-13-79 19 McDonald & Well Newton  
 date well completed firm name county well located

LANDOWNER:	description of formations encountered	from	to
<u>Louise McGee</u>	<u>clay &amp; sand</u>	<u>0</u>	<u>10</u>
<u>Hickory</u> (mailing address)	<u>sandy shale</u>	<u>10</u>	<u>30</u>
WELL LOCATION: sec <u>31</u> T <u>6</u> N R <u>13</u> E <u>1</u> miles <u>S</u> E of <u>Hickory</u> (distance) (direction) (nearest town)	<u>shale</u>	<u>30</u>	<u>60</u>
	<u>Rock &amp; shale</u>	<u>60</u>	<u>80</u>
WELL PURPOSE: <u>home</u> (home, irrigation, municipal, industrial)	<u>green sand &amp; sandy shale</u>	<u>80</u>	<u>90</u>
WELL COMPLETION DATA:	<u>shale &amp; Rock</u>	<u>90</u>	<u>210</u>
(1) diameter (inches) <u>4"</u>	<u>sandy shale</u>	<u>210</u>	<u>220</u>
(2) total depth (feet) <u>240'</u>	<u>sand</u>	<u>220</u>	<u>240</u>
(3) static water level (feet) <u>20'</u> below top of ground.			
(4) casing <u>PVC</u> , <u>57'</u> (material) (depth) <u>4"</u> (size) if telescope see back.			
(5) screen _____ (length) _____ (depth to top) (size) _____ (material)			
(6) pump <u>1/2</u> <u>1090M</u> (HP) (yield/gpm) <u>E</u> (type power)			
(7) electric log _____ (yes or no) (organization running log)			
(8) how well bottom plugged <u>open</u>			
DRILLERS REMARKS:			


Miss. Board of Water Comm.

JUL 24 1979

RECEIVED

If well telescopes please sketch and show depths.

GROUND LEVEL

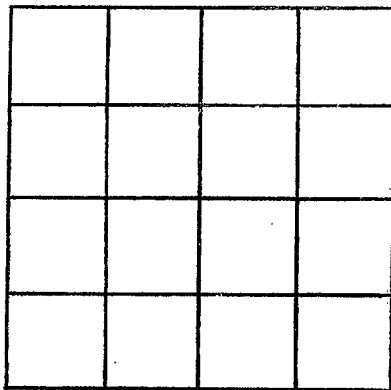

SECTION \_\_\_\_\_

Please indicate well location X.

ADDITIONAL INFORMATION

If more than one screen,  
show locations of each on sketch.