

Newton
M 2030

MISSISSIPPI
BOARD OF WATER COMMISSIONERS
416 North State Street
Jackson, Mississippi 39201

WATER WELL DRILLERS LOG

1-5-80 19 McDonald Mill Newton
date well completed firm name county well located

LANDOWNER:	description of formations encountered	from	to
Gene Cooley	clay & st sand	0	17
Rt Hickory (mailing address)	Rock & st sand	17	35
WELL LOCATION: sec 21 T. 6N R. 13E 3 miles NW of Chunky (distance) (direction) (nearest town)	fine sand	35	45
WELL PURPOSE: home (home, irrigation, municipal, industrial)	shale, & Rock st green sand	45	160
WELL COMPLETION DATA: (1) diameter (inches) 4" (2) total depth (feet) 200' (3) static water level (feet) 40' below top of ground. (4) casing PVC 50' (material) (depth) 4" (size) if telescope see back. (5) screen (length) (depth to top) (size) (material) (6) pump 3/4 690M (HP) (yield gpm) E (type power) (7) electric log (yes or no) (organization running log) (8) how well bottom plugged Open	sandy shale & sand	160	180
	sand	180	190
	shale	190	200
DRILLERS REMARKS:			


DEPT. OF NATURAL RESOURCES
BUREAU OF LAND & WATER RESOURCES

JAN 16 1980

RECEIVED

If well telescopes please sketch and show depths.

GROUND LEVEL

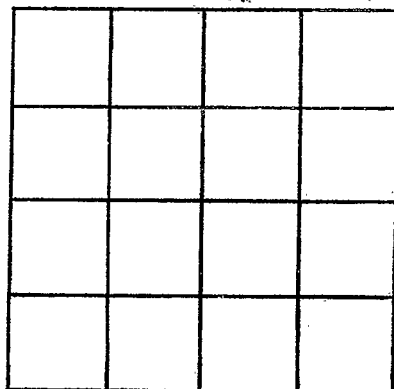

SECTION _____

Please indicate well location X.

ADDITIONAL INFORMATION

If more than one screen,
show locations of each on sketch.