

NEWTON
M 2031
2-20-80

MISSISSIPPI
BOARD OF WATER COMMISSIONERS
416 North State Street
Jackson, Mississippi 39201

WATER WELL DRILLERS LOG


2-20-80 19 *McDonald & Hill* *Newton*
date well completed firm name county well located

LANDOWNER:	description of formations encountered	from	to
<i>Ronnie Phelps</i>	<i>clay & sand</i>	<i>0</i>	<i>23</i>
<i>Cherkes</i> (mailing address)	<i>shale</i>	<i>95</i>	<i>42</i>
WELL LOCATION: sec. <i>14</i> T <i>6</i> N R. <i>13</i> E <i>3</i> miles N of <i>Cherkes</i> (distance) (direction) (nearest town)	<i>Rock shells & sand</i>	<i>42</i>	<i>60</i>
	<i>Rock & shale</i>	<i>60</i>	<i>135</i>
	<i>shale & sand</i>	<i>135</i>	<i>145</i>
WELL PURPOSE: <i>home</i> (home, irrigation, municipal, industrial)	<i>sand</i>	<i>145</i>	<i>180</i>
WELL COMPLETION DATA:			
(1) diameter (inches) <i>4"</i>			
(2) total depth (feet) <i>180'</i>			
(3) static water level (feet) <i>100'</i> below top of ground.			
(4) casing <i>PVC 40'</i> (material) (depth) <i>4"</i> If telescope see back. (size)			
(5) screen _____ (length) (depth to top) (size) (material)			
(6) pump <i>1/2</i> <i>1200</i> (HP) (yield/gpm) <i>E</i> (type power)			
(7) electric log (yes or no)			
(organization running log)			
(8) how well bottom plugged <i>open</i>			
DRILLERS REMARKS:			

DEPT. OF NATURAL RESOURCES
BUREAU OF LAND & WATER RESOURCES
FEB 20 1980
RECEIVED

If well telescopes please sketch and show depths.

GROUND LEVEL

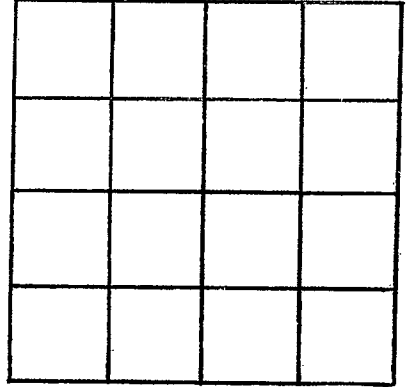

SECTION _____

Please indicate well location X.

ADDITIONAL INFORMATION

If more than one screen,
show locations of each on sketch.