

MISSISSIPPI DEPARTMENT OF NATURAL RESOURCES

Bureau of Land and Water Resources

Southport Mall

P.O. Box 10631

Jackson, Mississippi 39209

WATER WELL DRILLERS LOG

Newton
M 232
4-20-81

4-20-81 19
 date well completed

McDonald & Well
 firm name

Newton
 county well located

LANDOWNER:
P.C. Dean
Box 181, Chunky
 (mailing address)

description of formations encountered	from	to
<u>sandy clay</u>	<u>0</u>	<u>25</u>
<u>rocky shale</u>	<u>25</u>	<u>150</u>
<u>sand</u>	<u>150</u>	<u>180</u>
<u>shale</u>	<u>180</u>	<u>200</u>

WELL LOCATION:
 sec 21 T 6 N R 13 E
3 miles NW of Chunky
 (distance) (direction) (nearest town)

WELL PURPOSE: home
 (home, irrigation, municipal, industrial)


- WELL COMPLETION DATA:
- (1) diameter (inches) 4"
 - (2) total depth (feet) 200'
 - (3) static water level (feet) 10' below top of ground.
 - (4) casing PVC 40'
 (material) (depth)
4"
 (size) if telescope see back.
 - (5) screen _____
 (length) (depth to top)
 (size) (material)
 - (6) pump 1/2 24.0pm
 (HP) (yield gpm)
 (type power)
 - (7) electric log _____
 (yes or no)
 (organization running log)
 - (8) how well bottom plugged Open

DRILLERS REMARKS:

DEPT. OF NATURAL RESOURCES
 BUREAU OF LAND & WATER RESOURCES
 APR 23 1981
 RECEIVED

If well telescopes please
sketch and show depths.

GROUND LEVEL

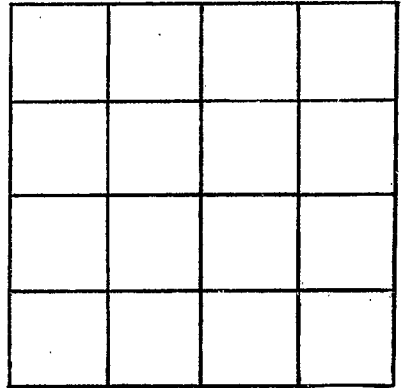

SECTION _____

Please indicate well location X.

ADDITIONAL INFORMATION

If more than one screen,
show locations of each on sketch.