

MISSISSIPPI DEPARTMENT OF NATURAL RESOURCES

Bureau of Land and Water Resources

Southport Mall

P.O. Box 10631

Jackson, Mississippi 39209

WATER WELL DRILLERS LOG

NEWTON
M 2033
4-21-81

4-21-81
 date well completed

McDonald & Hill
 firm name

Newton
 county well located

LANDOWNER:
Mary Jones
PO Box 1 Hickory
 (mailing address)

WELL LOCATION:
 sec. 32 T. 6 N. R. 13 E.
2 miles (distance) S.E. (direction) of Hickory (nearest town)

description of formations encountered	from	to
<u>clay st sand</u>	<u>0</u>	<u>10</u>
<u>shale</u>	<u>10</u>	<u>25</u>
<u>Rock shells</u>	<u>25</u>	<u>65</u>
<u>Rock & shale</u>	<u>65</u>	<u>170</u>
<u>shale & sand</u>	<u>170</u>	<u>185</u>
<u>sand</u>	<u>185</u>	<u>200</u>

WELL PURPOSE:
 (home, irrigation, municipal, industrial)

- WELL COMPLETION DATA:
- (1) diameter (inches) 2"
 - (2) total depth (feet) 200'
 - (3) static water level (feet) 15' below above top of ground.
 - (4) casing PVC 195'
 (material) (depth)
2"
 (size) if telescope see back.
 - (5) screen 5 195' to 200'
 (length) (depth to top)
2" PVC
 (size) (material)
 - (6) pump 1/2 44 P.M.
 (HP) (yld/gpm)
F
 (type power)
 - (7) electric log _____
 (yes or no)

 (organization running log)
 - (8) how well bottom plugged valve

DRILLERS REMARKS:


DEPT. OF NATURAL RESOURCES
 BUREAU OF LAND & WATER RESOURCES

APR 28 1981

RECEIVED

If well telescopes please sketch and show depths.

GROUND LEVEL

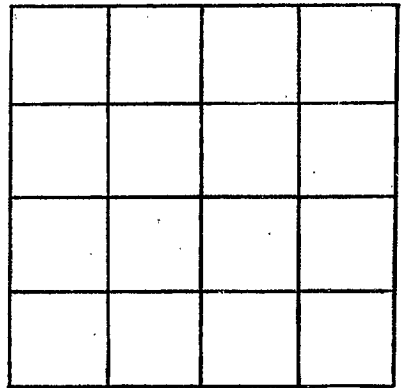

SECTION _____

Please indicate well location X.

ADDITIONAL INFORMATION

If more than one screen, show locations of each on sketch.