

MISSISSIPPI DEPARTMENT OF NATURAL RESOURCES

Bureau of Land and Water Resources

Southport Mall

P.O. Box 10631

Jackson, Mississippi 39209

WATER WELL DRILLERS LOG

Newton  
M 2037  
5-26-81  
5-26-81

date well completed

firm name

county well located

McDonald's Hill

Newton

LANDOWNER: 90 Leon Triple  
200 North Filate Ave.  
True Light Bapt. Church  
Chunky  
(mailing address)

description of formations encountered	from	to
<u>clay &amp; sand</u>	<u>0</u>	<u>20</u>
<u>shale + rock</u>	<u>20</u>	<u>135</u>
<u>st sand + shells</u>	<u>135</u>	<u>140</u>
<u>shale</u>	<u>140</u>	<u>150</u>
<u>sand st shale</u>	<u>150</u>	<u>180</u>

WELL LOCATION:  
sec. 27 T. 6 N R. 13 E  
2 miles (distance) S (direction) of Chunky (nearest town)

WELL PURPOSE: drinking  
(home, irrigation, municipal, industrial)

WELL COMPLETION DATA:

- (1) diameter (inches) 4"
- (2) total depth (feet) 180'
- (3) static water level (feet) 18' below above top of ground.
- (4) casing pic 39'  
(material) (depth)  
4" if telescope see back.  
(size)
- (5) screen \_\_\_\_\_  
(length) (depth to top)  
(size) (material)
- (6) pump 1/2 89 gpm  
(HP) (yield gpm)  
F  
(type power)
- (7) electric log \_\_\_\_\_  
(yes or no)  
(organization running log)
- (8) how well bottom plugged open

DEPT. OF NATURAL RESOURCES  
BUREAU OF LAND & WATER RESOURCES


JUN 2 - 1981

RECEIVED

DRILLERS REMARKS:

If well telescopes please  
sketch and show depths.

GROUND LEVEL

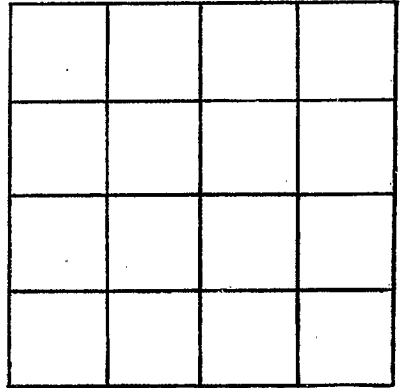

SECTION \_\_\_\_\_

Please indicate well location X.

ADDITIONAL INFORMATION

If more than one screen,  
show locations of each on sketch.