

MISSISSIPPI DEPARTMENT OF NATURAL RESOURCES

Bureau of Land and Water Resources

Southport Mall

P.O. Box 10631

Jackson, Mississippi 39209


WATER WELL DRILLERS LOG

Newton
M 2038
7/2/81
17-2-81
 date well completed

McDonald's Well
 firm name


Newton
 county well located

LANDOWNER:	description of formations encountered	from	to
<u>Ed Clark</u>			
<u>chunky</u> (mailing address)	<u>st Rock</u>	<u>22</u>	<u>27</u>
WELL LOCATION: sec <u>27</u> T <u>6</u> N R <u>13</u> E <u>9</u> miles <u>W</u> of <u>chunky</u> (distance) (direction) (nearest town)	<u>sandy shale</u>	<u>27</u>	<u>40</u>
WELL PURPOSE: <u>home</u> (home, irrigation, municipal, industrial)	<u>shale, st Rock</u>	<u>40</u>	<u>160</u>
WELL COMPLETION DATA: (1) diameter (inches) <u>4"</u>	<u>sand st shale</u>	<u>160</u>	<u>180</u>
(2) total depth (feet) <u>180'</u>			
(3) static water level (feet) <u>25'</u> below top of ground.			
(4) casing <u>PVC</u> , <u>40'</u> (material) (depth) <u>1/2</u> If telescope see back. (size)			
(5) screen _____ (length) _____ (depth to top) (size) _____ (material)			
(6) pump <u>1/2</u> <u>3 gpm</u> (HP) (yield gpm) <u>K</u> (type power)			
(7) electric log _____ (yes or no) (organization running log)			
(8) how well bottom plugged <u>good</u>			
DRILLERS REMARKS:			

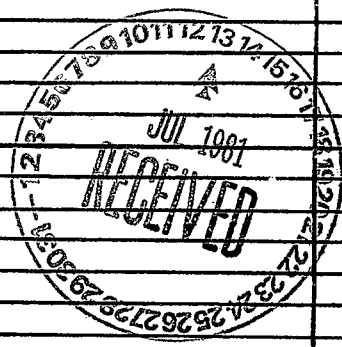

If well telescopes please sketch and show depths.

GROUND LEVEL

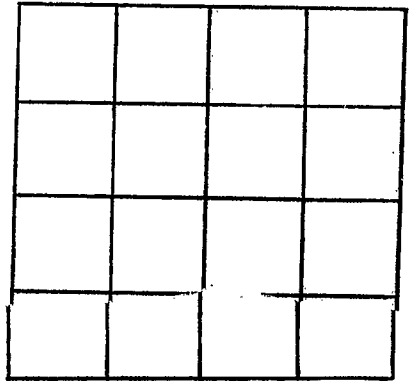

SECTION _____

Please indicate well location X.

ADDITIONAL INFORMATION

If more than one screen,
show locations of each on sketch.