

NEWTON

M 2040

7/24/81

MISSISSIPPI  
 BOARD OF WATER COMMISSIONERS  
 416 North State Street  
 Jackson, Mississippi 39201

WATER WELL DRILLERS LOG

7/24/81  
date well completed

1981 Jerry Dunning Co.  
firm name

Newton  
county well located

LANDOWNER:	description of formations encountered	from	to
George Johnson	yellow clay + sand	0	60
404 - Standan St, Newton	clay + rock	60'	160
(mailing address)	subday	160	180
	clay + rock	180	292
<b>WELL LOCATION:</b>			
sec. 19 T 60 N R 13 E S W A			
3 1/2 miles N of Hockley			
(distance) (direction) (nearest town)			
<b>WELL PURPOSE:</b>			
(home, irrigation, municipal, industrial)			
<b>WELL COMPLETION DATA:</b>			
(1) diameter (inches) 2"			
(2) total depth (feet) 292			
(3) static water level (feet) 100' below top of ground.			
(4) casing PVC 282 (material) (depth)			
_____ If telescope see back. (size)			
(5) screen 10' 282 (length) (depth to top)			
2" PVC (size) (material)			
(6) pump 1 4 (HP) (yield gpm)			
jet (type power)			
(7) electric log _____ (yes or no)			
_____ (organization running log)			
(8) how well bottom plugged Wash valve			
<b>DRILLERS REMARKS:</b>			


DEPT. OF WATER RESOURCES  
 BUREAU OF LAND & WATER RESOURCES

OCT 23 1981

RECEIVED

If well telescopes please sketch and show depths.

GROUND LEVEL

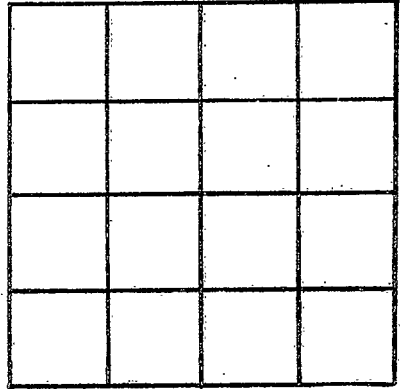

SECTION \_\_\_\_\_

Please indicate well location X.

**ADDITIONAL INFORMATION**


If more than one screen, show locations of each on sketch.