

NEWTON
 M 2041
 8-21-81

MISSISSIPPI DEPARTMENT OF NATURAL RESOURCES
 Bureau of Land and Water Resources
 Southport Mall
 P.O. Box 10631
 Jackson, Mississippi 39209
WATER WELL DRILLERS LOG

8-21-81 19 McDonald & Hill Newton
 date well completed firm name county well located

LANDOWNER:
C. A. Buckley
Rt # 1 Chunky
 (mailing address)

description of formations encountered	from	to
clay & sand	0	10
rock & shale	10	115
shale & sand	115	123
sand & shale	123	160
shale	160	185

WELL LOCATION:
 sec 26 T 6 N R 13 E
1 miles W of Chunky
 (distance) (direction) (nearest town)

shale & fine sand	185	210
-------------------	-----	-----

WELL PURPOSE: home
 (home, irrigation, municipal, industrial)

- WELL COMPLETION DATA:
- diameter (inches) 4"
 - total depth (feet) 260'
 - static water level (feet) 3' below above top of ground.
 - casing PVC, 20'
 (material) (depth)
4"
 (size) if telescope see back.
 - screen _____
 (length) (depth to top)
 (size) (material)
 - pump 2 70.0M
 (HP) (yield gpm)
 (type power)
 - electric log _____
 (yes or no)
 (organization running log)
 - how well bottom plugged open

fine sand	210	250
shale	250	260

DEPT. OF NATURAL RESOURCES
 BUREAU OF LAND & WATER RESOURCES


AUG 31 1981

RECEIVED

DRILLERS REMARKS:

If well telescopes please sketch and show depths.

GROUND LEVEL

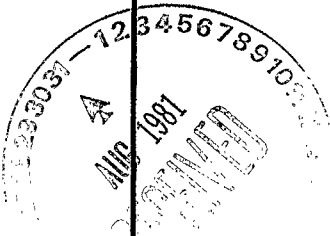

SECTION _____

Please indicate well location X.

ADDITIONAL INFORMATION

If more than one screen, show locations of each on sketch.