

NEWTON
M 2042
8-20-81


MISSISSIPPI DEPARTMENT OF NATURAL RESOURCES
Bureau of Land and Water Resources
Southport Mall
P.O. Box 10631
Jackson, Mississippi 39209
WATER WELL DRILLERS LOG

8-20-81 19 McDonald & Hill Newton
date well completed firm name county well located

LANDOWNER:	description of formations encountered	from	to
<u>Robert Swann</u>	<u>clay & sand</u>	<u>0</u>	<u>15</u>
<u>Pt # 1 Chenky</u> (mailing address)	<u>sandy shale</u>	<u>15</u>	<u>23</u>
WELL LOCATION: sec <u>22</u> T <u>6 N</u> R <u>13 E</u> <u>2</u> miles <u>NW</u> of <u>Chenky</u> (distance) (direction) (nearest town)	<u>shale</u>	<u>25</u>	<u>55</u>
WELL PURPOSE: <u>home</u> (home, irrigation, municipal, industrial)	<u>Rock & shells</u>	<u>55</u>	<u>80</u>
WELL COMPLETION DATA: (1) diameter (inches) <u>4"</u>	<u>green sand & sandy shale</u>	<u>80</u>	<u>87</u>
(2) total depth (feet) <u>240'</u>	<u>shale & rock</u>	<u>87</u>	<u>205</u>
(3) static water level (feet) <u>92'</u> below above top of ground.	<u>shale & sand</u>	<u>205</u>	<u>220</u>
(4) casing <u>PVC 50'</u> (material) (depth) <u>4"</u> if telescope see back. (size)	<u>sand & shale</u>	<u>220</u>	<u>240</u>
(5) screen _____ (length) (depth to top) (size) (material)			
(6) pump <u>1/2</u> <u>89.00</u> (HP) (yield/gpm) <u>K</u> (type power)			
(7) electric log _____ (yes or no) (organization running log)			
(8) how well bottom plugged <u>open</u>			
DRILLERS REMARKS:			

If well telescopes please sketch and show depths.

GROUND LEVEL

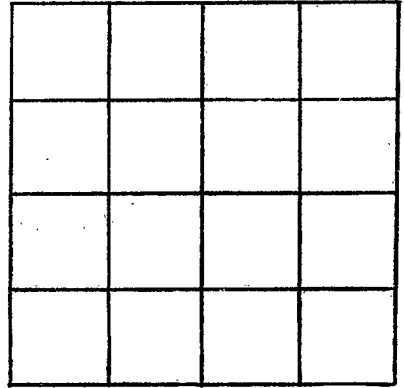

SECTION _____


Please indicate well location X.

ADDITIONAL INFORMATION

RECEIVED

AUG 24 1981

DEPT. OF NATURAL RESOURCES
BUREAU OF LAND & WATER RESOURCES

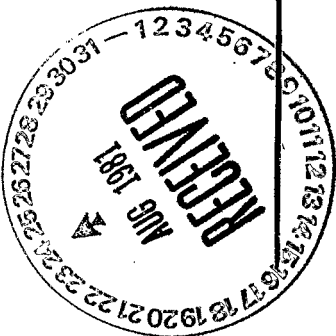

If more than one screen, show locations of each on sketch.