

NEWTON
M 2043
9-29-81

MISSISSIPPI DEPARTMENT OF NATURAL RESOURCES
Bureau of Land and Water Resources
Southport Mall
P.O. Box 10631
Jackson, Mississippi 39209
WATER WELL DRILLERS LOG

9-29-81 date well completed
McDonald's Well firm name
Newton county well located

LANDOWNER:
Luther Chaney
Chenby (mailing address)

description of formations encountered	from	to
Clay	0	30
st Rock	30	35
sandy shale	35	43
shale	43	55
shale & rock	55	155
shale & sand	155	168
sand & shale	168	200

WELL LOCATION:
sec 27 T 6 N R 3 E
1 1/2 miles W of Chenby (distance) (direction) (nearest town)

WELL PURPOSE: home (home, irrigation, municipal, industrial)


- WELL COMPLETION DATA:
- (1) diameter (inches) 4"
 - (2) total depth (feet) 200'
 - (3) static water level (feet) 36' below top of ground.
 - (4) casing PVC 55' (material) (depth)
4" (size) if telescope see back.
 - (5) screen (length) (depth to top) (size) (material)
 - (6) pump 1/2 6 gpm (HP) (yield gpm)
F (type power)
 - (7) electric log (yes or no)
(organization running log)
 - (8) how well bottom plugged open

DRILLERS REMARKS:

DEPT. OF NATURAL RESOURCES
BUREAU OF LAND & WATER RESOURCES
OCT 5 1981
RECEIVED

If well telescopes please sketch and show depths.

GROUND LEVEL

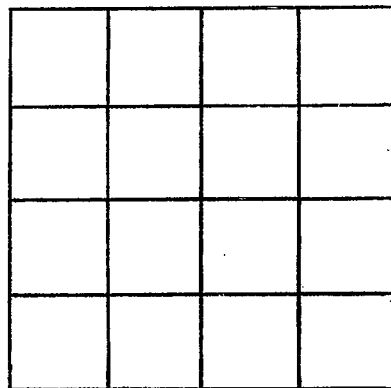

SECTION _____

Please indicate well location X.

ADDITIONAL INFORMATION

If more than one screen,
show locations of each on sketch.