

MISSISSIPPI DEPARTMENT OF NATURAL RESOURCES

Bureau of Land and Water Resources

Southport Mall

P.O. Box 10631

Jackson, Mississippi 39209

WATER WELL DRILLERS LOG

Newton
14
2044

9-29-82

McDonald & Well

Newton

date well completed

firm name

county well located

LANDOWNER:

Chip Land

Chukby

(mailing address)

WELL LOCATION:

sec 26 T 4 N S R 13 E W
1 miles N of Chukby
(distance) (direction) (nearest town)

WELL PURPOSE:

home
(home, irrigation, municipal, industrial)

WELL COMPLETION DATA:

- (1) diameter (inches) 4"
- (2) total depth (feet) 180'
- (3) static water level (feet) 40' below above top of ground.
- (4) casing PDC, 110,
(material) (depth)
4" if telescope see back.
(size)
- (5) screen _____
(length) (depth to top)
(size) (material)
- (6) pump 1/2 800
(HP) (yield gpm)
E
(type power)
- (7) electric log _____
(yes or no)
(organization running log)
- (8) how well bottom plugged open

description of formations encountered

from to

clay & sand

0 30

shale & rock

30 130

shale & green sand

130 150

water course sand

150 180

DRILLERS REMARKS:


DEPT. OF NATURAL RESOURCES
BUREAU OF LAND & WATER RESOURCES

OCT - 1 1982

RECEIVED

If well telescopes please sketch and show depths.

GROUND LEVEL

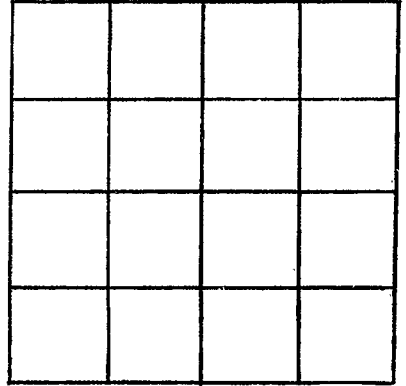

SECTION _____

Please indicate well location X.

ADDITIONAL INFORMATION

If more than one screen,
show locations of each on sketch.