

Newton  
M  
2045

MISSISSIPPI DEPARTMENT OF NATURAL RESOURCES  
Bureau of Land and Water Resources  
Southport Mall  
P.O. Box 10631  
Jackson, Mississippi 39209  
WATER WELL DRILLERS LOG

11-15-82 date well completed  
McDonald & Hill firm name  
Newton county well located


LANDOWNER:	description of formations encountered	from	to
Tommy F. Wilson Pt # 1 Box 114A, Hickory (mailing address)			
WELL LOCATION:	shale	10	25
sec. 33 T 6N R 13 E 2 miles S E of Hickory (distance) (direction) (nearest town)	Rock & shells	25	45
WELL PURPOSE: home (home, irrigation, municipal, industrial)	shale & Rock	45	180
WELL COMPLETION DATA:	fine sand & shale	180	200
(1) diameter (inches) 9"	coarse sand		
(2) total depth (feet) 215'			
(3) static water level (feet) 10' below top of ground.			
(4) casing PVC 2 1/2" (material), 210' (depth) 2" (size) if telescope see back.			
(5) screen 5' (length), 210' to 215' (depth to top) 2" (size), PVC (material)			
(6) pump 1/2 HP (type power), 89 gpm (yield/gpm)			
(7) electric log (yes or no) (organization running log)			
(8) how well bottom plugged			
DRILLERS REMARKS:			

DEPT. OF NATURAL RESOURCES  
BUREAU OF LAND & WATER RESOURCES

NOV 22 1982  
RECEIVED

If well telescopes please sketch and show depths.

GROUND LEVEL

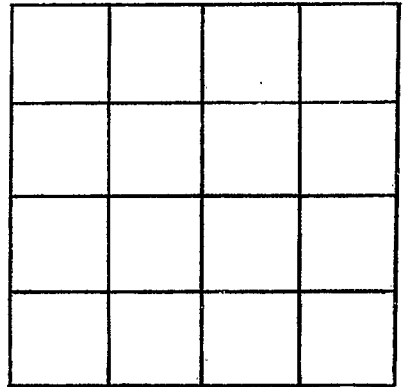

SECTION \_\_\_\_\_

Please indicate well location X.

ADDITIONAL INFORMATION

If more than one screen,  
show locations of each on sketch.