

Newton  
M  
2046

MISSISSIPPI DEPARTMENT OF NATURAL RESOURCES  
 Bureau of Land and Water Resources  
 Southport Mall  
 P.O. Box 10631  
 Jackson, Mississippi 39209  
**WATER WELL DRILLERS LOG**

4-27-83 19 McDonalds Hill Newton  
 date well completed firm name county well located

LANDOWNER:  
J. F. Buckley  
Rt# chunky  
 (mailing address)

WELL LOCATION:  
 sec 26 T 6 N R 13 E  
1/2 miles SW of Chunky  
 (distance) (direction) (nearest town)

WELL PURPOSE: home  
 (home, irrigation, municipal, industrial)

WELL COMPLETION DATA:

- (1) diameter (inches) 4"
- (2) total depth (feet) 240
- (3) static water level (feet) 90' below above top of ground.
- (4) casing Pvc, 58',  
 (material) (depth)  
4'  
 (size) if telescope see back.
- (5) screen —, —  
 (length) (depth to top)  
 (size) (material)
- (6) pump 34, 890 m  
 (HP) (yield gpm)  
F  
 (type power)
- (7) electric log —  
 (yes or no)  
 (organization running log)
- (8) how well bottom plugged open

description of formations encountered	from	to
clay	0	22
shale	22	59
Rubble shell	59	80
glow sand	80	85
RAK 9 shale	85	210
shale st sand	210	220
concrete sand	220	240

DEPT. OF NATURAL RESOURCES  
 BUREAU OF LAND & WATER RESOURCES


MAY 2 - 1983

**RECEIVED**

DRILLERS REMARKS:

If well telescopes please  
sketch and show depths.

GROUND LEVEL

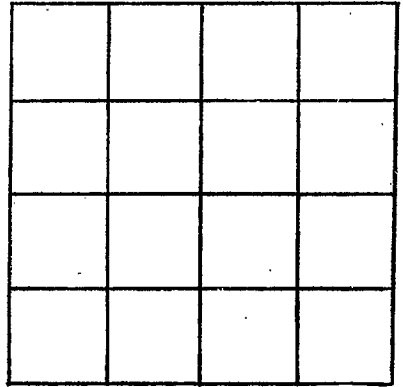

SECTION \_\_\_\_\_

Please indicate well location X.

ADDITIONAL INFORMATION

If more than one screen,  
show locations of each on sketch.