

Newton
M
2047

MISSISSIPPI
BOARD OF WATER COMMISSIONERS
416 North State Street
Jackson, Mississippi 39201

WATER WELL DRILLERS LOG

4-28 1983 McDonald & Hill Newton
date well completed firm name county well located

LANDOWNER:
James McCormick
Hickory, MS
(mailing address)

description of formations encountered	from	to
Clay	0	16
Shale	16	36
Rock & Shells	36	185
Shale & Sand	185	195
Sand	195	220

WELL LOCATION:
sec. 32 T. 6 N. R. 13 E
S W
(distance) miles (direction) of (nearest town)

WELL PURPOSE:
(home, irrigation, municipal, industrial)

- WELL COMPLETION DATA:
- (1) diameter (inches) 4"
 - (2) total depth (feet) 220
 - (3) static water level (feet) 10' below top of ground.
 - (4) casing PVC, 37' (material) (depth)
4" (size) if telescope see back.
 - (5) screen (length) (depth to top)
(size) (material)
 - (6) pump 1 HP, 80 GPM (HP) (yield gpm)
Jet (type power)
 - (7) electric log (yes or no)
 - (8) how well bottom plugged Open
end

DRILLERS REMARKS:


DEPT. OF NATURAL RESOURCES
BUREAU OF LAND & WATER RESOURCES

MAY 9 - 1983

RECEIVED

If well telescopes please
sketch and show depths.

GROUND LEVEL

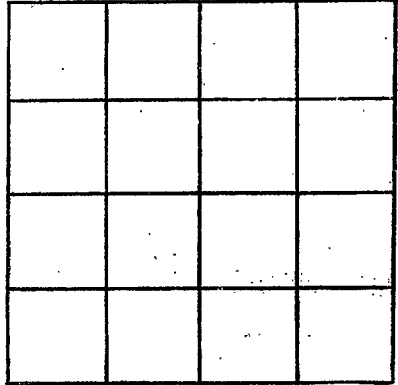

SECTION _____

Please indicate well location X.

ADDITIONAL INFORMATION

If more than one screen,
show locations of each on sketch.