

MISSISSIPPI DEPARTMENT OF NATURAL RESOURCES

Bureau of Land and Water Resources

Southport Mall

P.O. Box 10631

Jackson, Mississippi 39209

WATER WELL DRILLERS LOG

Newton
M
2048

6-6-1983 McDonald's Newton
date well completed firm name county well located

LANDOWNER: John Ivy
Chunky Miss
(mailing address)

description of formations encountered	from	to
<u>Play</u>	<u>0</u>	<u>10</u>
<u>Red Sand</u>	<u>10</u>	<u>19</u>
<u>Rocky shale</u>	<u>19</u>	<u>125</u>
<u>Shale</u>	<u>125</u>	<u>130</u>
<u>Sands</u>	<u>130</u>	<u>140</u>
<u>Sand</u>	<u>140</u>	<u>180</u>

WELL LOCATION:
sec 24 T 6A S R 130 W
2 miles NORTH of Chunky
(distance) (direction) (nearest town)

WELL PURPOSE: HOME
(home, irrigation, municipal, industrial)

- WELL COMPLETION DATA:
- (1) diameter (inches) 4"
 - (2) total depth (feet) 180'
 - (3) static water level (feet) 88' below top of ground.
 - (4) casing PVC 105'
(material) (depth)
(size) If telescope see back.
 - (5) screen 0
(length) (depth to top)
(size) (material)
 - (6) pump 1 5
(HP) (yield gpm)
(type power)
 - (7) electric log yes or no
(organization running log)
 - (8) how well bottom plugged OPEN

DRILLERS REMARKS:


DEPT. OF NATURAL RESOURCES
BUREAU OF LAND & WATER RESOURCES

JUN 13 1983

RECEIVED

If well telescopes please
sketch and show depths.

GROUND LEVEL

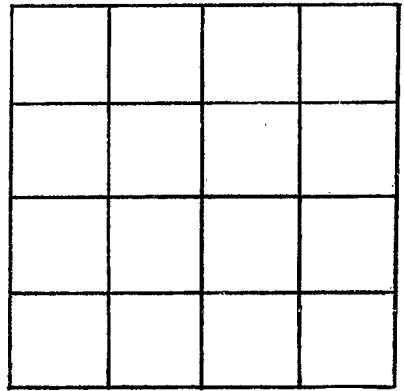

SECTION _____

Please indicate well location X.

ADDITIONAL INFORMATION

If more than one screen,
show locations of each on sketch.