

MISSISSIPPI DEPARTMENT OF NATURAL RESOURCES

Bureau of Land and Water Resources

Southport Mall

P.O. Box 10631

Jackson, Mississippi 39209

WATER WELL DRILLERS LOG

| |
|--------|
| Newton |
| M |
| 2052 |

4-25-84 19
date well completed

McDonald & Hill
firm name

Newton
county well located

LANDOWNER:
Faye Johnson
Chunky
(mailing address)

WELL LOCATION:
sec. 22 T 6 N R 13 E
2 miles NW of Chunky
(distance) (direction) (nearest town)

WELL PURPOSE: home
(home, irrigation, municipal, industrial)

- WELL COMPLETION DATA:
- diameter (inches) 4"
 - total depth (feet) 240'
 - static water level (feet) 90' below top of ground.
 - casing PVC 50' (material) (depth)
4" (size) if telescope see back.
 - screen (length) (depth to top)
(size) (material)
 - pump 1/2 (HP) 89 gpm (material) (yield gpm)
E (type power)
 - electric log (yes or no)
(organization running log)
 - how well bottom plugged open

| description of formations encountered | from | to |
|---------------------------------------|------|-----|
| clay & sand | 0 | 25 |
| shale | 25 | 53 |
| Rock + shell D | 53 | 80 |
| cross sand + sandy shale | 80 | 85 |
| shale + Rock | 85 | 205 |
| shale + sand | 205 | 220 |
| sand | 220 | 240 |


DEPT. OF NATURAL RESOURCES
BUREAU OF LAND & WATER RESOURCES

MAY - 2 1984
RECEIVED

DRILLERS REMARKS:

If well telescopes please sketch and show depths.

GROUND LEVEL

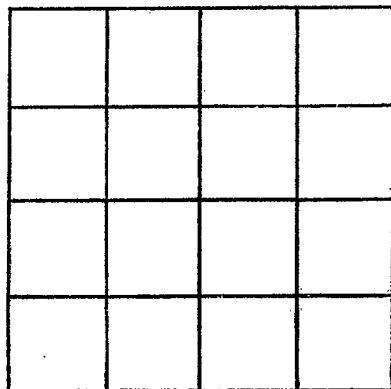

SECTION _____

Please indicate well location X.

ADDITIONAL INFORMATION

If more than one screen, show locations of each on sketch.