

MISSISSIPPI DEPARTMENT OF NATURAL RESOURCES
Bureau of Land and Water Resources
 Southport Mall
 P.O. Box 10631
 Jackson, Mississippi 39209
WATER WELL DRILLERS LOG

Newton
M
255

6-28-84 19 McDonald & Hill Newton
 date well completed firm name county well located

LANDOWNER:
Steve Dybowski
RT # 1, Chunky
 (mailing address)

description of formations encountered	from	to
<u>clay</u>	<u>0</u>	<u>20</u>
<u>sand</u>	<u>20</u>	<u>25</u>
<u>st rock & shells</u>	<u>25</u>	<u>45</u>
<u>shale & sand</u>	<u>45</u>	<u>170</u>
<u>shale st sand</u>	<u>170</u>	<u>180</u>
<u>sand</u>	<u>180</u>	<u>200</u>

WELL LOCATION:
 sec 27 T 6 N R 13 E
1 miles W of Chunky
 (distance) (direction) (nearest town)

WELL PURPOSE: Home
 (home, irrigation, municipal, industrial)

WELL COMPLETION DATA:


- diameter (inches) 4"
- total depth (feet) 200'
- static water level (feet) 35 below above top of ground.
- casing PVC, 48'
 (material) (depth)
4" if telescope see back.
 (size)
- screen _____
 (length) (depth to top)
 (size) (material)
- pump 1/2 800m
 (HP) (yield/gpm)
 (type power)
- electric log _____
 (yes or no)
 (organization running log)
- how well bottom plugged Open

DRILLERS REMARKS:

MISSISSIPPI DEPARTMENT OF NATURAL RESOURCES
 BUREAU OF LAND & WATER RESOURCES
 JUL - 2 1984
RECEIVED

If well telescopes please
sketch and show depths.

GROUND LEVEL

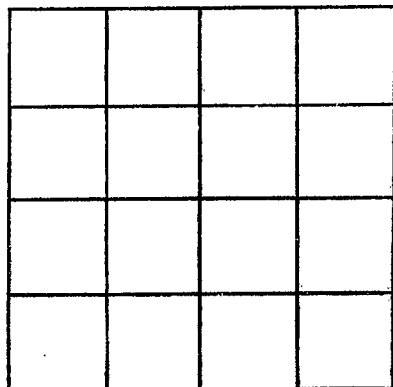

SECTION _____

Please indicate well location X.

ADDITIONAL INFORMATION

If more than one screen,
show locations of each on sketch.