

MISSISSIPPI DEPARTMENT OF NATURAL RESOURCES

Bureau of Land and Water Resources

Southport Mall

P.O. Box 10631

Jackson, Mississippi 39209

WATER WELL DRILLERS LOG

NEWTON
M
2056

7-3-84 19

McDonald Hill

Newton

date well completed

firm name

county well located

LANDOWNER:

Billy Ferguson
Rt # 2 Decatur
 (mailing address)

description of formations encountered

from

to

<u>clay + sand</u>	<u>0</u>	<u>32</u>
<u>sandy shale</u>	<u>32</u>	<u>60</u>
<u>shale</u>	<u>50</u>	<u>83</u>
<u>Rock + shales</u>	<u>83</u>	<u>105</u>
<u>green sand + sandy shale</u>	<u>105</u>	<u>115</u>
<u>Rock + shale</u>	<u>115</u>	<u>235</u>
<u>shale st sand</u>	<u>235</u>	<u>245</u>
<u>sand</u>	<u>245</u>	<u>260</u>

WELL LOCATION:

sec. 7 T. 6 N. R. 17 E. S. 5 W. 4 miles N of Makou
 (distance) (direction) (nearest town)

WELL PURPOSE:

home
 (home, irrigation, municipal, industrial)

WELL COMPLETION DATA:

- (1) diameter (inches) 4"
- (2) total depth (feet) 260'
- (3) static water level (feet) 90 below above top of ground.
- (4) casing PVC, 90'
 (material) (depth)
4" if telescope see back.
 (size)
- (5) screen _____
 (length) (depth to top)
 (size) (material)
- (6) pump 1/2 890M
 (HP) (yield gpm)
F
 (type power)
- (7) electric log _____
 (yes or no)
 (organization running log)
- (8) how well bottom plugged open

DEPT. OF NATURAL RESOURCES
 BUREAU OF LAND & WATER RESOURCES

JUL 10 1984


RECEIVED

DRILLERS REMARKS:

120' Hole planned to

If well telescopes please
sketch and show depths.

GROUND LEVEL

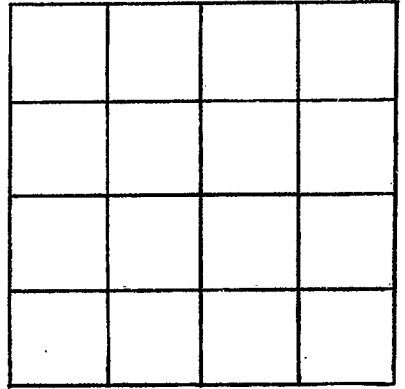

SECTION _____

Please indicate well location X.

ADDITIONAL INFORMATION

If more than one screen,
show locations of each on sketch.