

Newton
M
2057

MISSISSIPPI DEPARTMENT OF NATURAL RESOURCES
 Bureau of Land and Water Resources
 Southport Mall
 P.O. Box 10631
 Jackson, Mississippi 39209
WATER WELL DRILLERS LOG

8-13-84 19 McDonald & Hill Newton
 date well completed firm name county well located

LANDOWNER:
Bill Robinson
PO #1 Hickory
 (mailing address)

WELL LOCATION:
 sec. 13 T 6 N R. 13 E
4 miles NW of Chumbly
 (distance) (direction) (nearest town)

WELL PURPOSE: none
 (home, irrigation, municipal, industrial)

- WELL COMPLETION DATA:
- (1) diameter (inches) 4"
 - (2) total depth (feet) 220'
 - (3) static water level (feet) 45' below top of ground.
 - (4) casing PVC, 30' (material) (depth)
4" if telescope see back. (size)
 - (5) screen _____ (length) _____ (depth to top)
 _____ (size) _____ (material)
 - (6) pump 3/4" 890m (HPY) (yield gpm)
h (type power)
 - (7) electric log _____ (yes or no)
 _____ (organization running log)
 - (8) how well bottom plugged open

description of formations encountered	from	to
<u>clay</u>	<u>0</u>	<u>18</u>
<u>shale</u>	<u>18</u>	<u>36</u>
<u>Rock & shells</u>	<u>36</u>	<u>60</u>
<u>green sand & sandy shale</u>	<u>60</u>	<u>65</u>
<u>shale & Rock</u>	<u>65</u>	<u>175</u>
<u>shale & sand</u>	<u>175</u>	<u>185</u>
<u>sand</u>	<u>185</u>	<u>220</u>

DEPT. OF NATURAL RESOURCES
 BUREAU OF LAND & WATER RESOURCES


AUG 20 1984

RECEIVED

DRILLERS REMARKS:

If well telescopes please sketch and show depths.

GROUND LEVEL

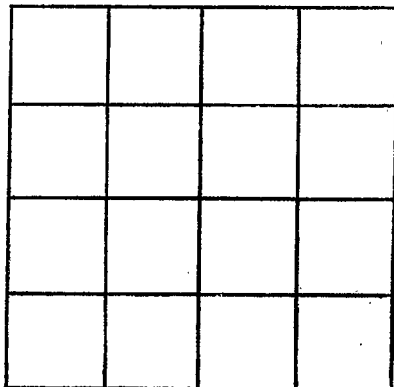

SECTION _____

Please indicate well location X.

ADDITIONAL INFORMATION

If more than one screen,
show locations of each on sketch.