

MISSISSIPPI DEPARTMENT OF NATURAL RESOURCES

Bureau of Land and Water Resources

Southport Mall

P.O. Box 10631

Jackson, Mississippi 39209

WATER WELL DRILLERS LOG

NEWTON
MI 2059
3-85

3 1985 McDonald + Hill Inc Newton
 date well completed firm name county well located

LANDOWNER: Glen Hull
 B#1 Box 181A
 Chunky, MS
 (mailing address)

description of formations encountered	from	to
Clay + sand	0	20
Rock + shale	20	130
St gum sand	130	145
Course sand	145	180

WELL LOCATION:
 sec 25 T 6 N R 13 E
 S W
 1/2 miles north of Chunky
 (distance) (direction) (nearest town)

WELL PURPOSE: none
 (home, irrigation, municipal, industrial)

WELL COMPLETION DATA:

(1) diameter (inches) 4

(2) total depth (feet) 180

(3) static water level (feet) 87 below top of ground.

(4) casing 4" PVC 111' (material) (depth)
 (size) If telescope see back.

(5) screen (length) (depth to top)
 (size) (material)

(6) pump 10 (HP) (yield gpm)
 (type power)

(7) electric log (yes or no)
 (organization running log)

(8) how well bottom plugged open end

RECEIVED


MAR 26 1985

Department of Natural Resources
 Bureau of Land & Water Resources

DRILLERS REMARKS:
 set pump 120'

If well telescopes please sketch and show depths.

GROUND LEVEL

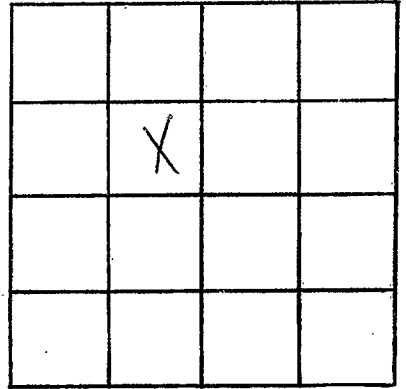

SECTION 25

Please indicate well location X.

ADDITIONAL INFORMATION

If more than one screen,
show locations of each on sketch.