

Newton  
 M 2060  
 7-12-85

MISSISSIPPI DEPARTMENT OF NATURAL RESOURCES  
 Bureau of Land and Water Resources  
 Southport Mall  
 P.O. Box 10631  
 Jackson, Mississippi 39209  
 WATER WELL DRILLERS LOG

7-12-85 19 McDonald + Hilline NEWTON  
 date well completed firm name county well located

LANDOWNER: A.G. HARRIS  
 Rt #1 Hickory MS  
 (mailing address)

description of formations encountered	from	to
CLAY SAND	0	18
SHALE	18	25
SHELLS STRUCK	25	50
SHALE STRUCK	50	180
SHALE	180	185
SAND	185	202

WELL LOCATION:  
 sec. 20 T. 6 N. R. 13 E.  
 2 miles EAST of Hickory  
 (distance) (direction) (nearest town)

WELL PURPOSE: HOME  
 (home, irrigation, municipal, industrial)


- WELL COMPLETION DATA:
- (1) diameter (inches) 2"
  - (2) total depth (feet) 202'
  - (3) static water level (feet) 30' below top of ground.
  - (4) casing PVC, 192' (material) (depth)  
 2" (size) if telescope see back.
  - (5) screen 10' length, 192' depth to top  
 2" (size), PVC (material)
  - (6) pump (HP) (yield gpm)  
 (type power)
  - (7) electric log (yes or no)  
 (organization running log)
  - (8) how well bottom plugged VALVE

DRILLERS REMARKS:

RECEIVED  
 JUL 15 1985  
 Department of Natural Resources  
 Bureau of Land & Water Resources

If well telescopes please sketch and show depths.

GROUND LEVEL

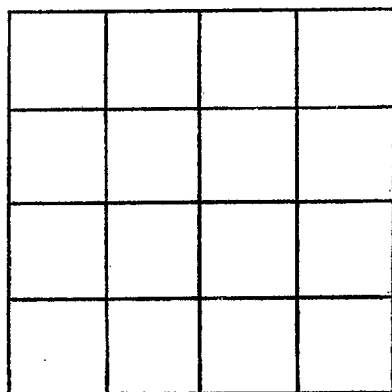

SECTION \_\_\_\_\_

Please indicate well location X.

ADDITIONAL INFORMATION

If more than one screen,  
show locations of each on sketch.