

MISSISSIPPI DEPARTMENT OF NATURAL RESOURCES

Bureau of Land and Water Resources

Southport Mall

P.O. Box 10631

Jackson, Mississippi 39209

WATER WELL DRILLERS LOG

Newton
M 2061
7-10-85

7-10-85
19

McDonald & Hice

Newton

date well completed

firm name

county well located

LANDOWNER:

M. F. Gentry

description of formations encountered

from

to

Plot #1

CLAY
SAND

0 16
16 70

Hickory, MS.
(mailing address)

WELL LOCATION:

sec. 20 T. 6 N R. 13 E
3 miles NE of Hickory
(distance) (direction) (nearest town)

WELL PURPOSE:

Home
(home, irrigation, municipal, industrial)

WELL COMPLETION DATA:

- (1) diameter (inches) 2
- (2) total depth (feet) 70
- (3) static water level (feet) 33 below top of ground.
- (4) casing PVC 60
(material) (depth)

(size) if telescope see back.

- (5) screen 10 60-70
(length) (depth to top)
- 2 PVC
(size) (material)

- (6) pump 56 gpm
(HP) (yield gpm)

(type power)

- (7) electric log (yes or no)

(organization running log)

- (8) how well bottom plugged

Screen

RECEIVED
JUL 15 1985


Department of Natural Resources
Bureau of Land & Water Resources

DRILLERS REMARKS:

Set pump jet at 59 feet

If well telescopes please sketch and show depths.

GROUND LEVEL

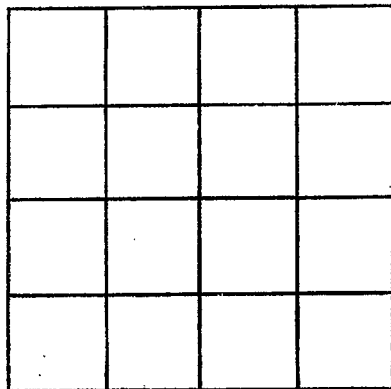

SECTION _____

Please indicate well location X.

ADDITIONAL INFORMATION

If more than one screen, show locations of each on sketch.