

MISSISSIPPI DEPARTMENT OF NATURAL RESOURCES

Bureau of Land and Water Resources

Southport Mall

P.O. Box 10631

Jackson, Mississippi 39209

WATER WELL DRILLERS LOG

Newton  
M 262  
7-12-85

7-12-85 date well completed 19 McDonald + Hill firm name Newton county well located

LANDOWNER: Mike Bracken  
Rt 1 Hickory MS  
(mailing address)

description of formations encountered

from to

CLAY	0	16
SHALE	16	47
SAND	47	80
SHALE STRATA	80	160
SHALE	160	190
SAND	190	220

WELL LOCATION:

sec 29 T. 6 N. R. 13 E  
3 miles NE of Hickory  
(distance) (direction) (nearest town)

WELL PURPOSE: Home  
(home, irrigation, municipal, industrial)

WELL COMPLETION DATA:

- (1) diameter (inches) 4 1/2
- (2) total depth (feet) 220
- (3) static water level (feet) 30' below top of ground.
- (4) casing PVC 84' (material) (depth)  
4" (size) if telescope see back.
- (5) screen (length) (depth to top)  
(size) (material)
- (6) pump (HP) (yield gpm)  
(type power)
- (7) electric log (yes or no)  
(organization running log)
- (8) how well bottom plugged OPEN

RECEIVED


JUL 17 1985

DRILLERS REMARKS:

Department of Natural Resources  
Bureau of Land & Water Resources

If well telescopes please sketch and show depths.

GROUND LEVEL

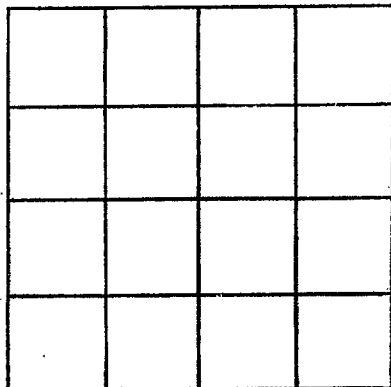

SECTION \_\_\_\_\_

Please indicate well location X.

ADDITIONAL INFORMATION

If more than one screen, show locations of each on sketch.